




REVISIONS		
DATE	DESCRIPTION	BY.

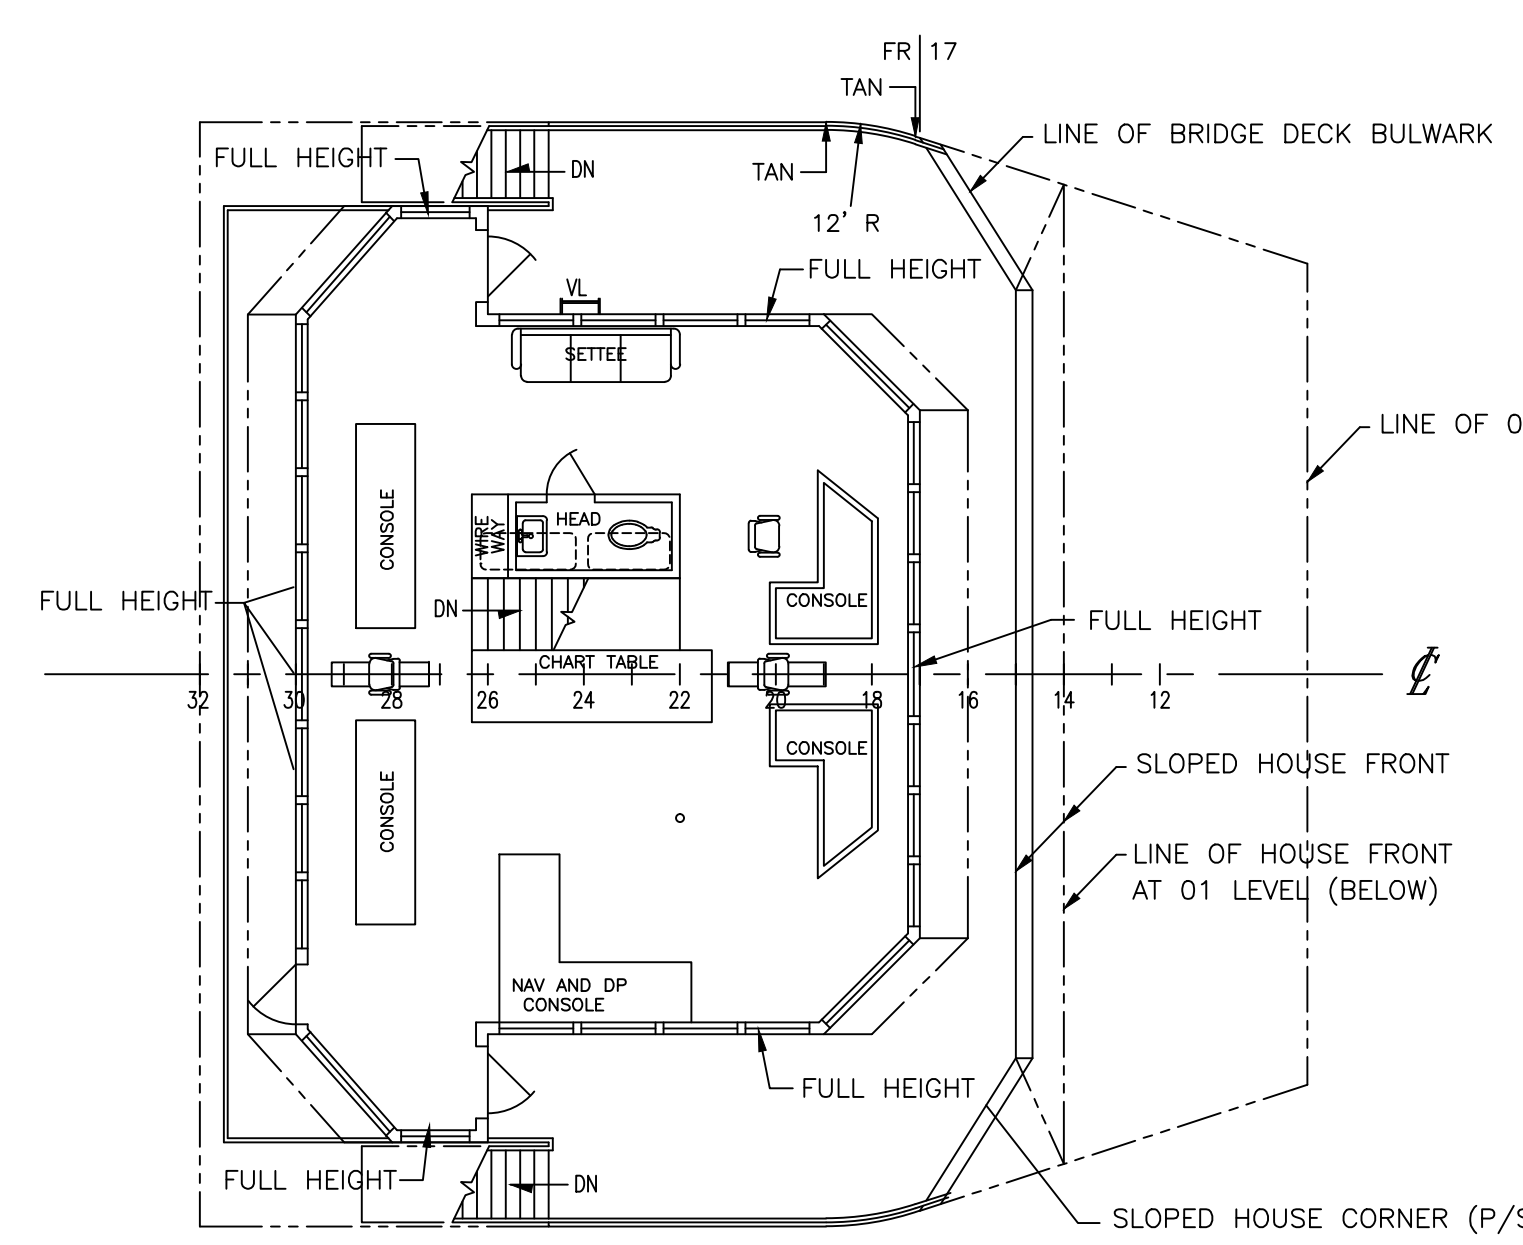


BRIDGE

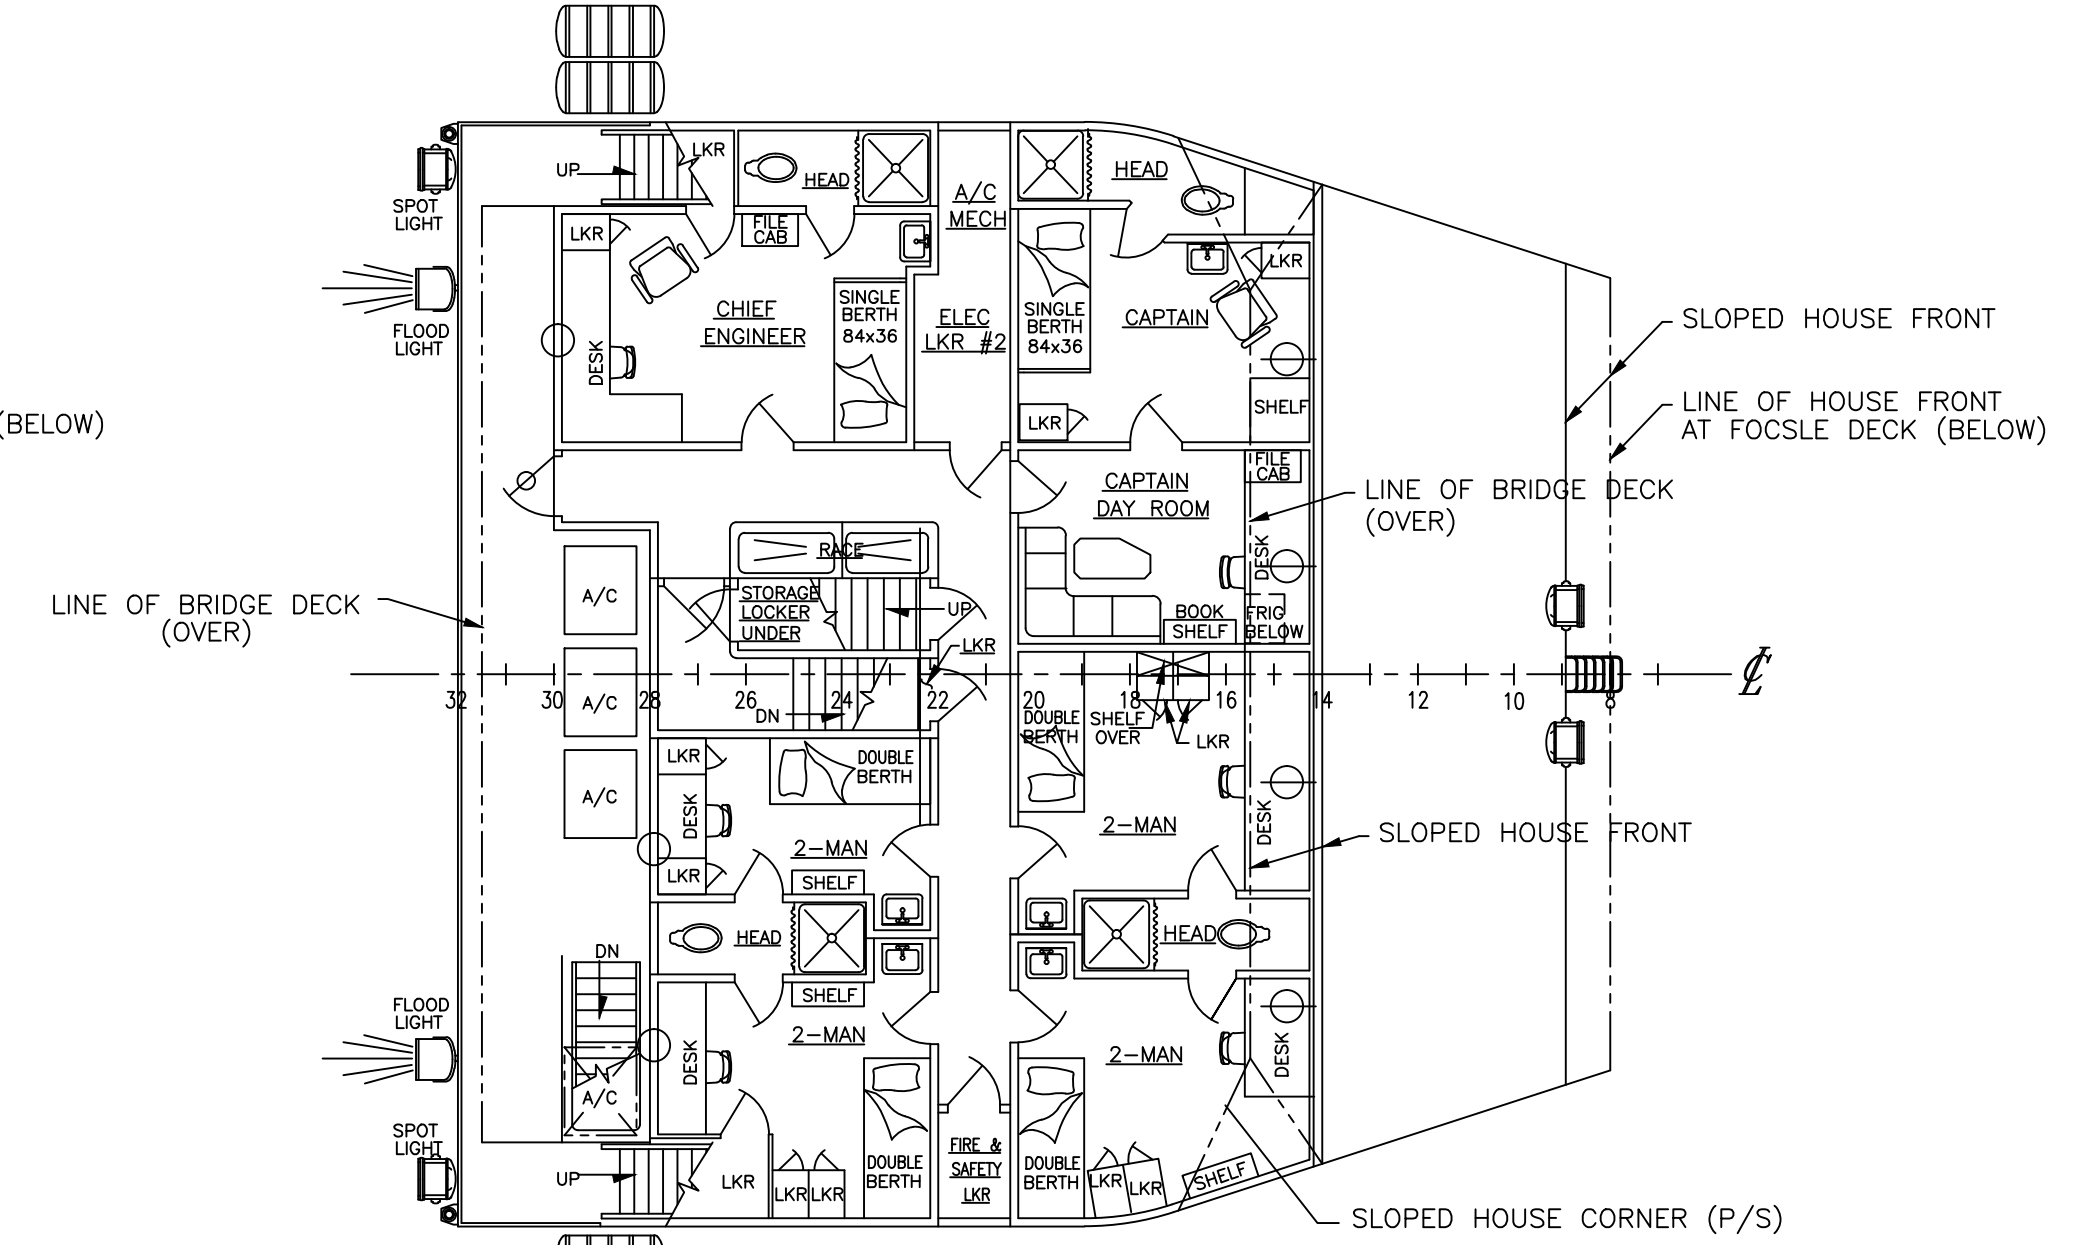

01 LEVEL

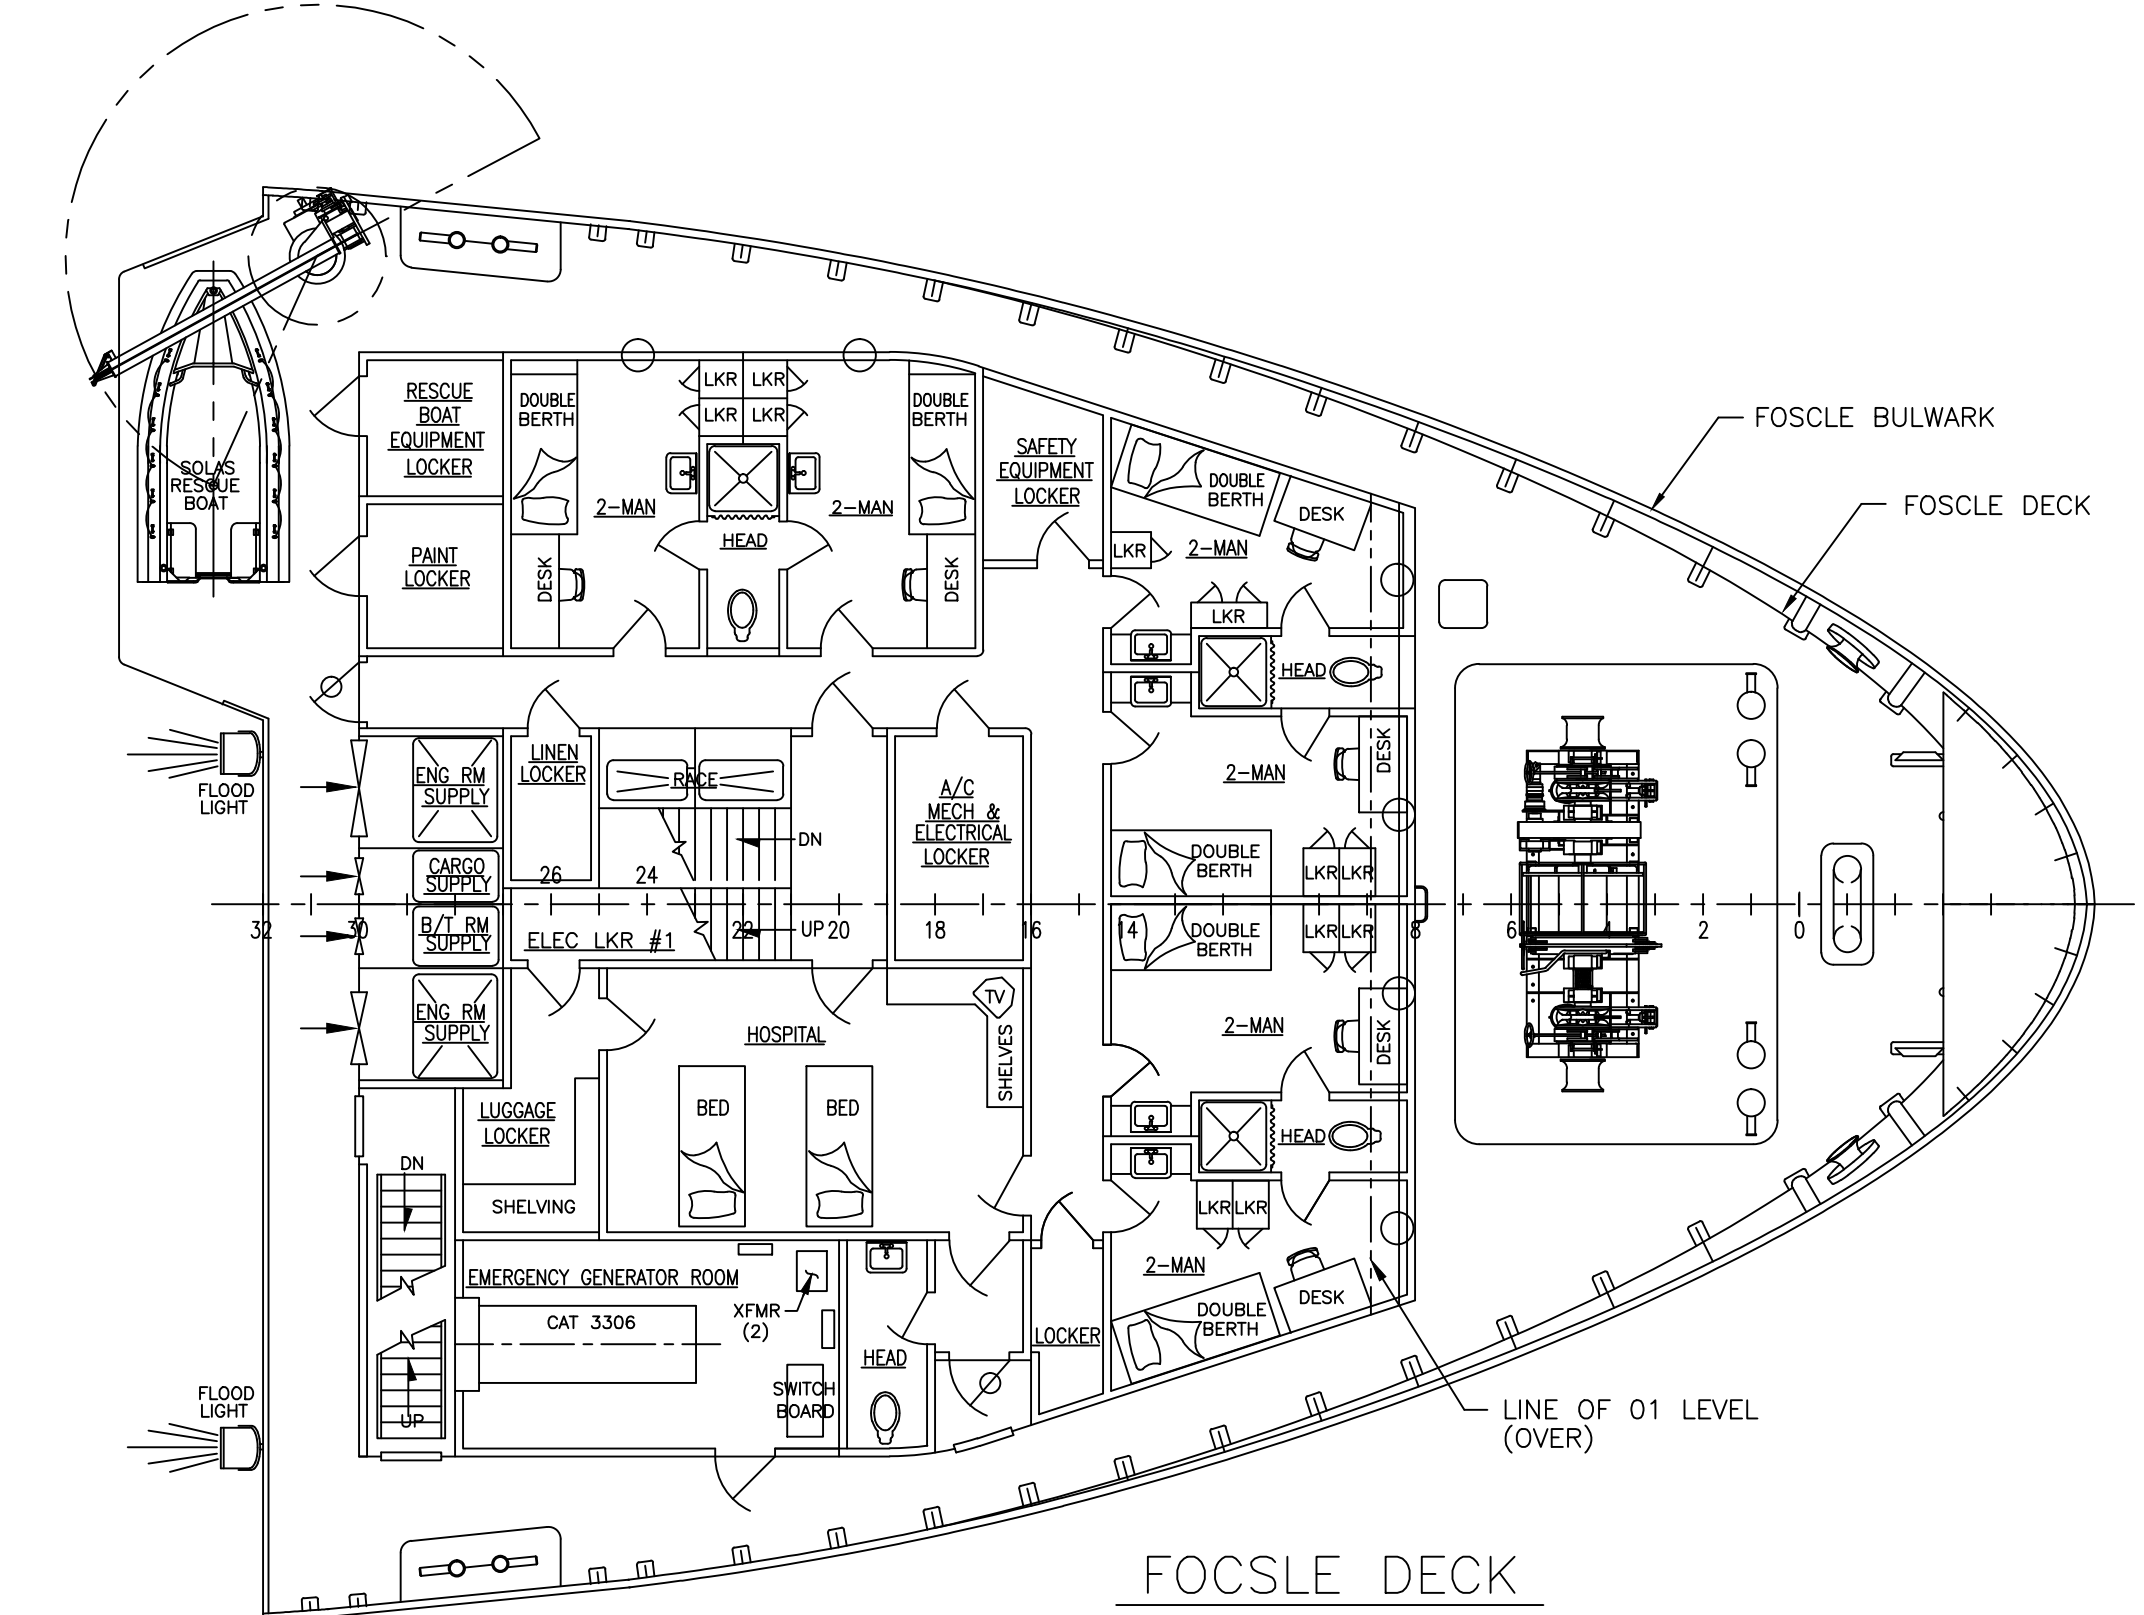

FOCSLE DECK

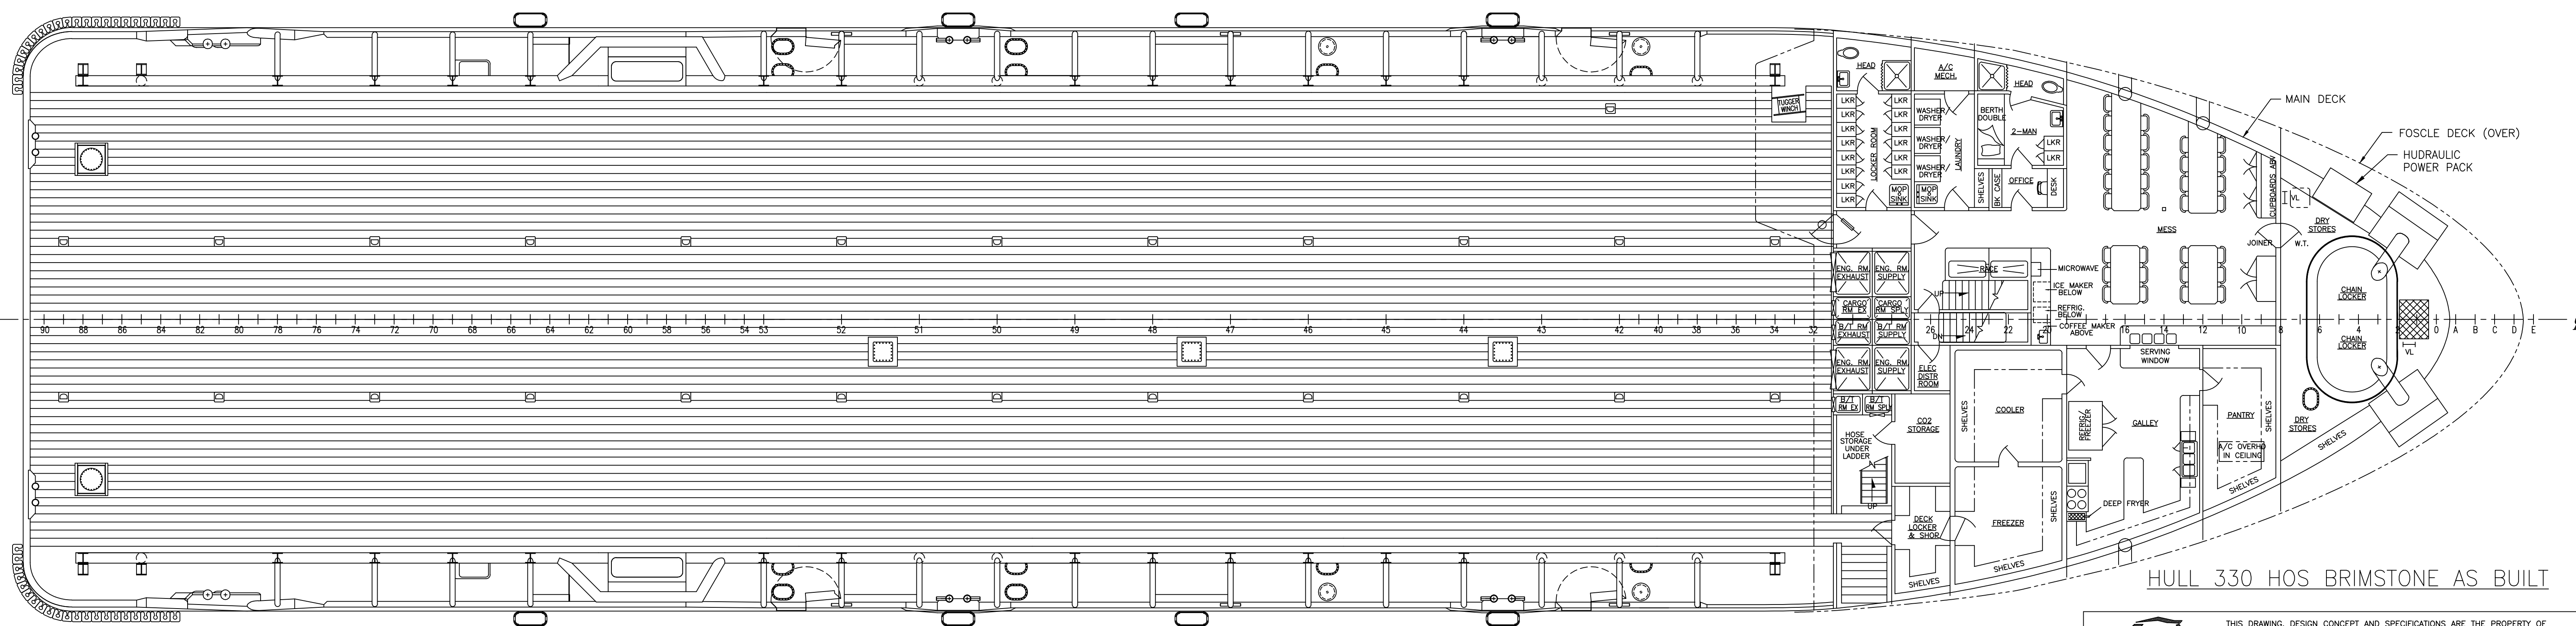

MAIN DECK ARRANGEMENT
20'-0" - 22'-0" ABOVE BASELINE

HULL 330 HOS BRIMSTONE AS BUILT

HOS HORNBECK OFFSHORE SERVICES

THIS DRAWING, DESIGN CONCEPT AND SPECIFICATIONS ARE THE PROPERTY OF HORNBECK OFFSHORE SERVICES AND ARE FURNISHED ON A CONFIDENTIAL BASIS WITH AN EXPRESSED UNDERSTANDING THAT THEY WILL NOT BE COPIED IN ANY MANNER USED FOR MANUFACTURE, SOLD, TRANSFERRED, NOR USED TO THE DETRIMENT OF SAID FIRM WITHOUT WRITTEN PERMISSION.

DRAWN BY:	EBDG	260'-0" X 60'-0" X 21'-0" W		REV.
CH'KD. BY:	JAT	GENERAL ARRANGEMENT		
APP'D. BY:	JAT	SCALE: 1/8"=1'-0"	DATE: 1/19/01	4
APP'D. BY:	JAT	DRAWING # 1.002	DATE: LVI HULL #330	
		SHEET 1 OF 1		