



REVISIONS		
DATE	DESCRIPTION	BY.
02/08/01	REV 1 1. REMOVED FIRE MONITOR 2. MODIFIED PILOT HOUSE TOP RAILING 3. UPDATED ANCHOR POCKET	EBDG
3/14/01	REV 2 - INCORPORATED OWNER MARK-UPS OF 2/20/01	EBDG
7/31/01	REV 3 - INCORPORATED OWNER/USCG COMMENTS PER USCG APPROVAL OF 5/2/01	EBDG
7/31/02	REV 4 - REVISED TO SUIT VESSEL AS BUILT	EBDG
11/16/12	REV 5 - REVISED TO ADD VESSEL NAME TO GENERIC 265W CLASS OUTBOARD PROFILE	WDT

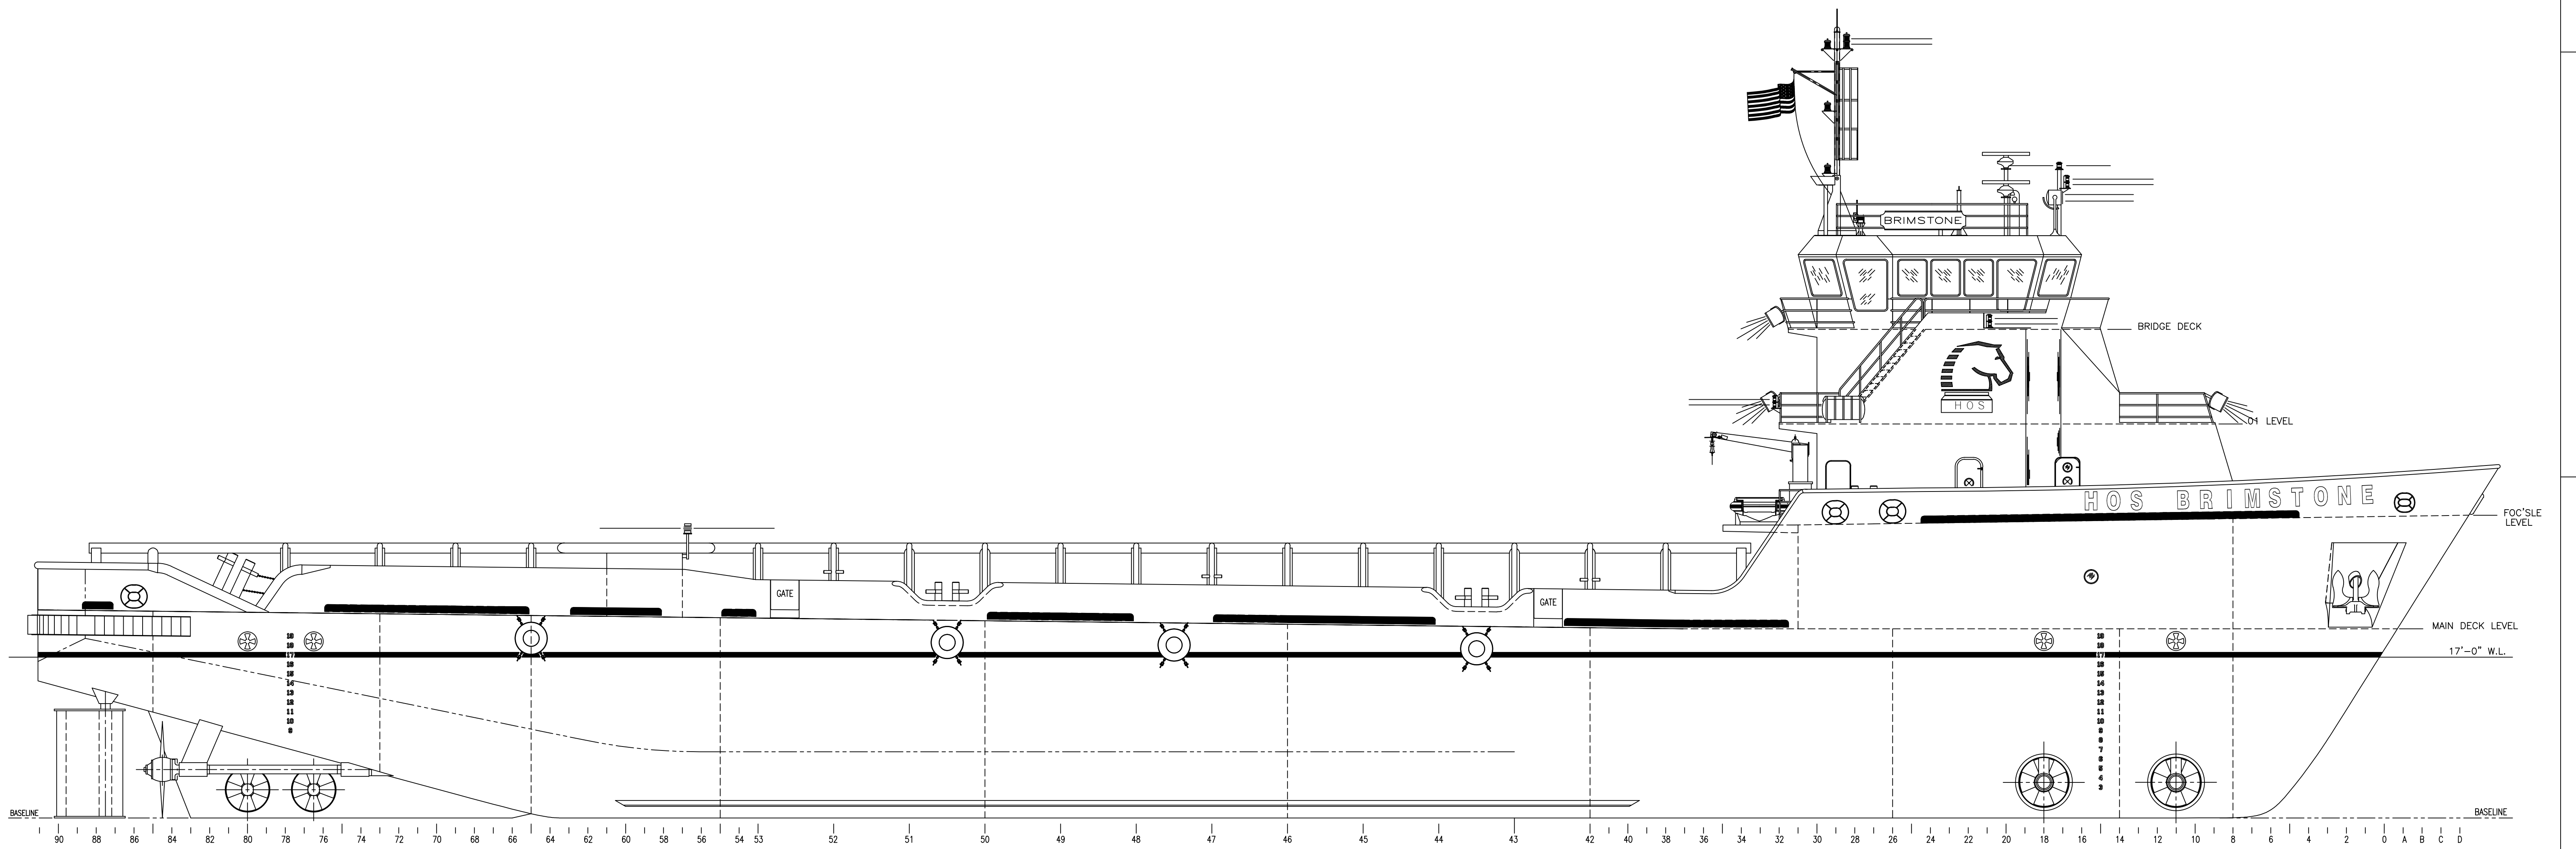

OUTBOARD PROFILE

HULL 330 HOS BRIMSTONE AS BUILT

		<small>THIS DRAWING, DESIGN CONCEPT AND SPECIFICATIONS ARE THE PROPERTY OF HORNBECK OFFSHORE SERVICES AND ARE FURNISHED ON A CONFIDENTIAL BASIS WITH AN EXPRESSED UNDERSTANDING THAT THEY WILL NOT BE COPIED IN ANY MANNER USED FOR MANUFACTURE, SOLD, TRANSFERRED, NOR USED TO THE DETRIMENT OF SAID FIRM WITHOUT WRITTEN PERMISSION.</small>	
HORNBECK OFFSHORE SERVICES			
DRAWN BY: EBDG	260'-0" X 60'-0" X 21'-0" W		
CH'KD. BY: JAT	OUTBOARD PROFILE		
APP'D. BY: JAT	SCALE: 1/8"=1'-0"	DATE: 1/19/01	REV.
TASK:	DRAWING # 1.001	LVI HULL #330 SHEET 1 OF 1	5