

8

7

6

5


4

3

2

1

REVISIONS		
REV	DESCRIPTION	DATE
1	LOWER B.T. TUNNELS & RESIZED SKEG AS PER OWNER	7-12-00
2	CARGO & BULL RAIL CHANGES AS PER OWNER	7-20-00
3	CHANGE TITLE BLOCK TO HULL #329	1-30-01
4	REVISED AS PER OWNER ADDED NEW QUARTERS	10-1-01
6	ADDED BT. EXHAUST PIPES	10-30-01
7	ADDED BT. EXHAUST STACK & TRANSDUCER DAWT	11-28-01
8	ADDED A-FRAME BOOM	1-17-02
9	AS BUILT	3-12-02
10	DEMOLIBLIZED SONSUB	3-3-06
11	ADDED LIFERAFT TO FOCSELE DECK REMOVED TIRE FENDERING ADDED D-FENDERING	1-27-10
12	ADDED CRANE AND 01 DK EXTENSION	2-8-11

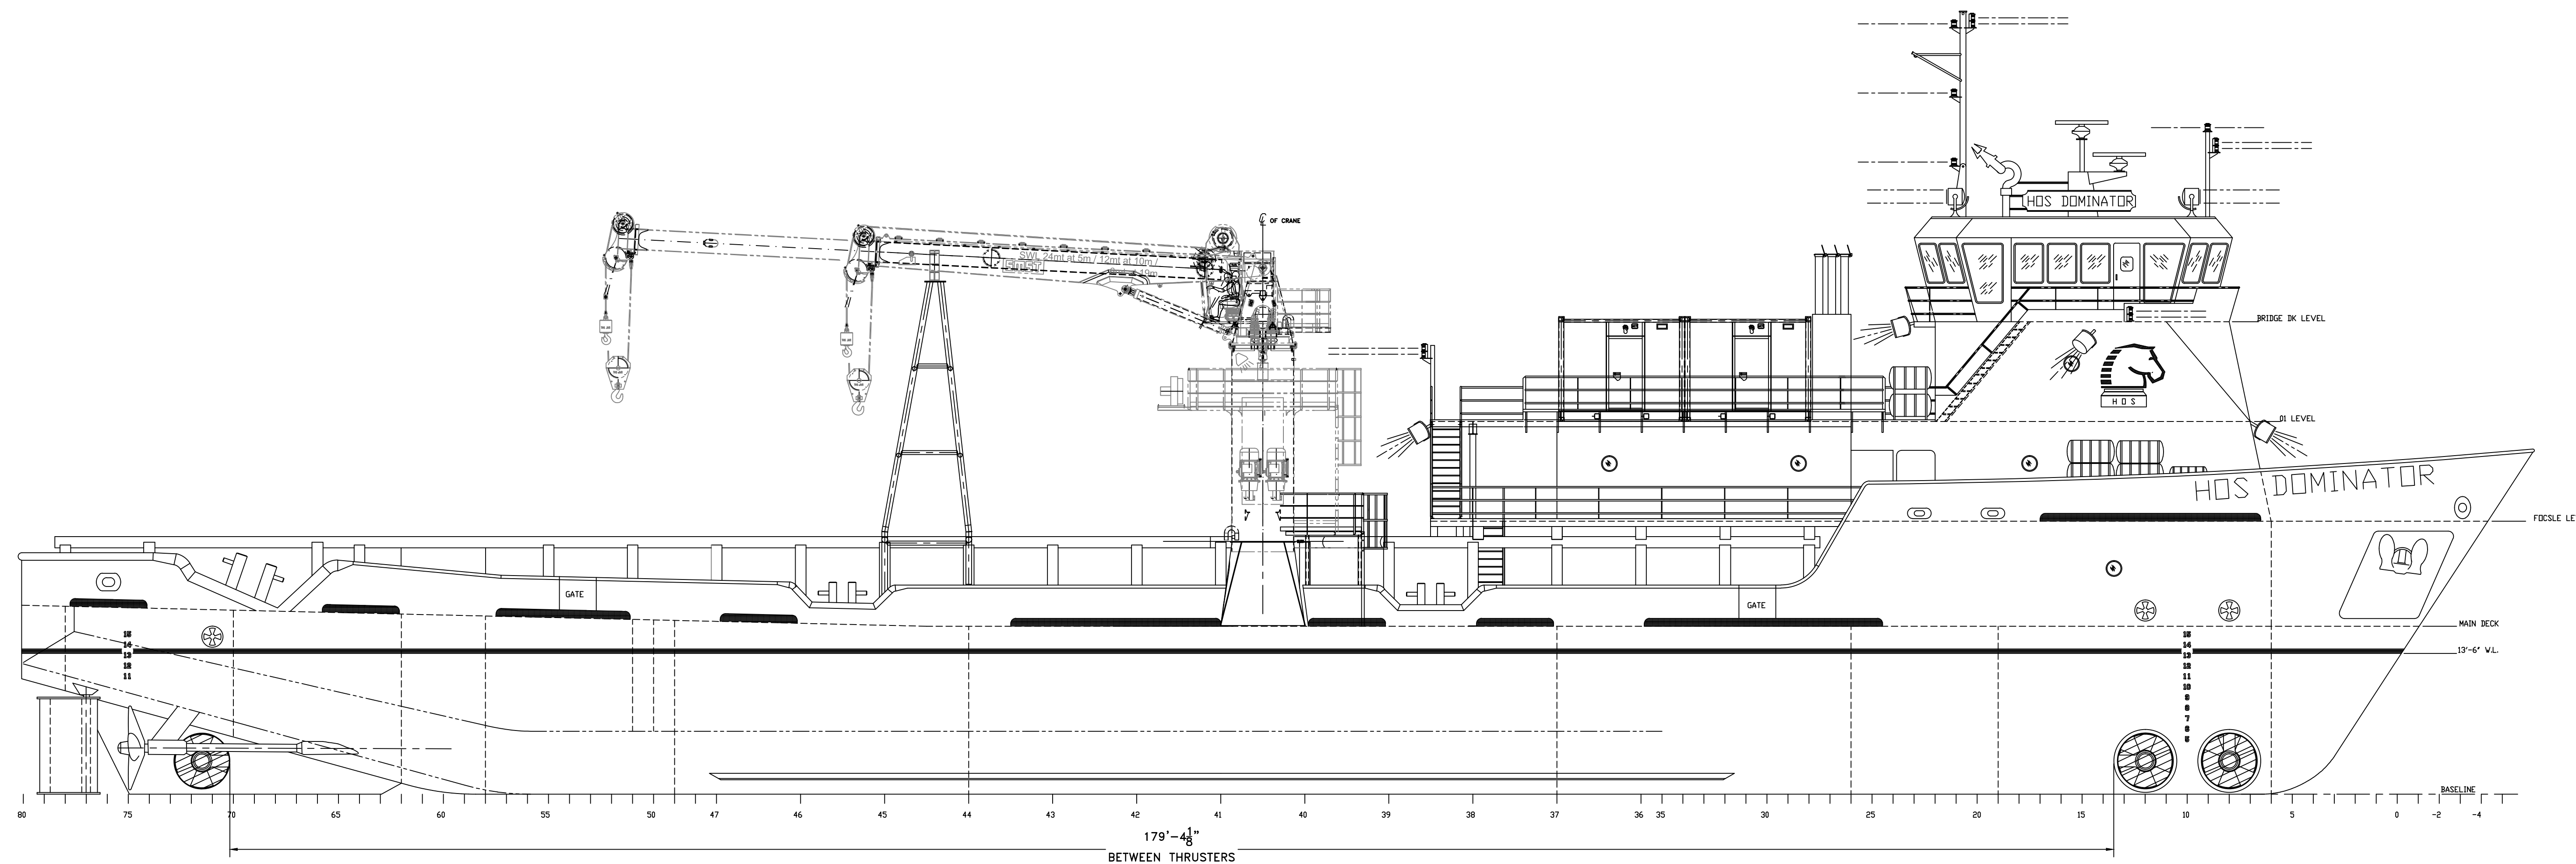

PROFILE

179'-4 1/8"  
BETWEEN THRUSTERS

THIS DRAWING, DESIGN CONCEPT AND SPECIFICATIONS ARE THE PROPERTY OF HORNBECK OFFSHORE SERVICES AND ARE FURNISHED ON A CONFIDENTIAL BASIS WITH AN EXPRESSED UNDERSTANDING THAT THEY WILL NOT BE COPIED IN ANY MANNER USED FOR MANUFACTURE, SOLD, TRANSFERRED, NOR USED TO THE DETRIMENT OF SAID FIRM WITHOUT WRITTEN PERMISSION. HOS ©

**HORNBECK OFFSHORE SERVICES**

DRAWN BY: JONATHAN L.E.JEUNE	240'-0" X 54'-0" X 17'-0" OSV		
CH'KD. BY: MIKE JANNISE	OUTBOARD PROFILE		
APP'D. BY:	SCALE: 1/8" = 1'-0"	DATE: 4-7-2000	REV.
APP'D. BY:	DRAWING # 1.001	LVI HULL #329 SHEET 1 OF 1	12

8

7

6

5

4

3

2

1