




REVISIONS		
DATE	DESCRIPTION	BY.

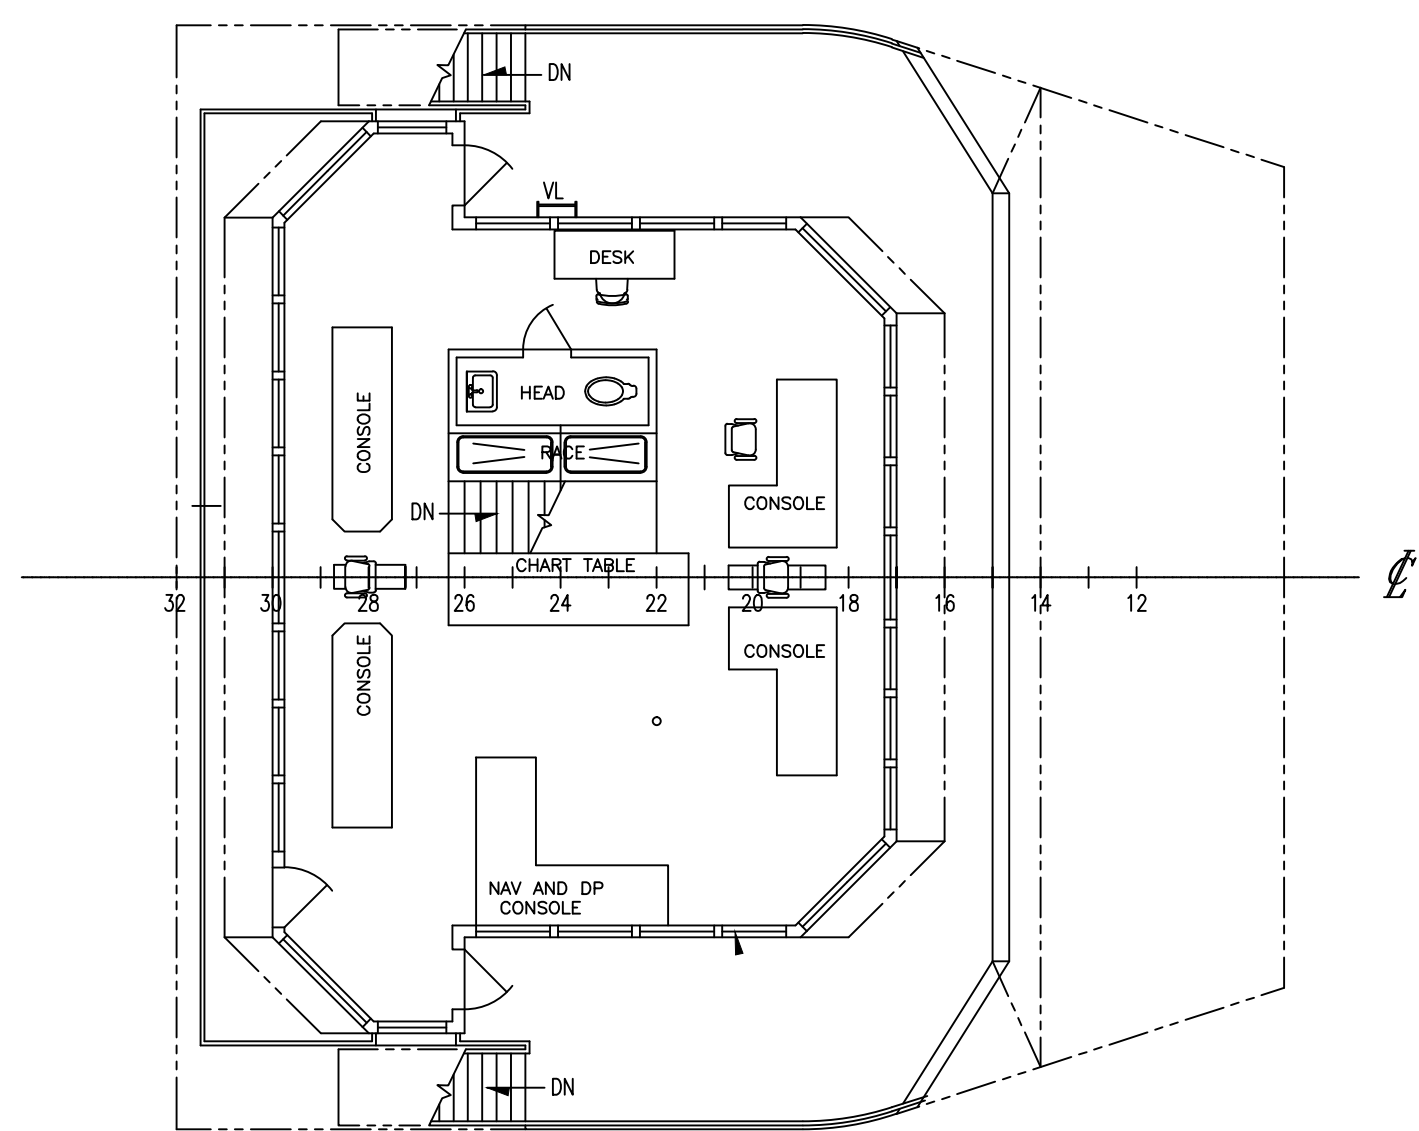


BRIDGE

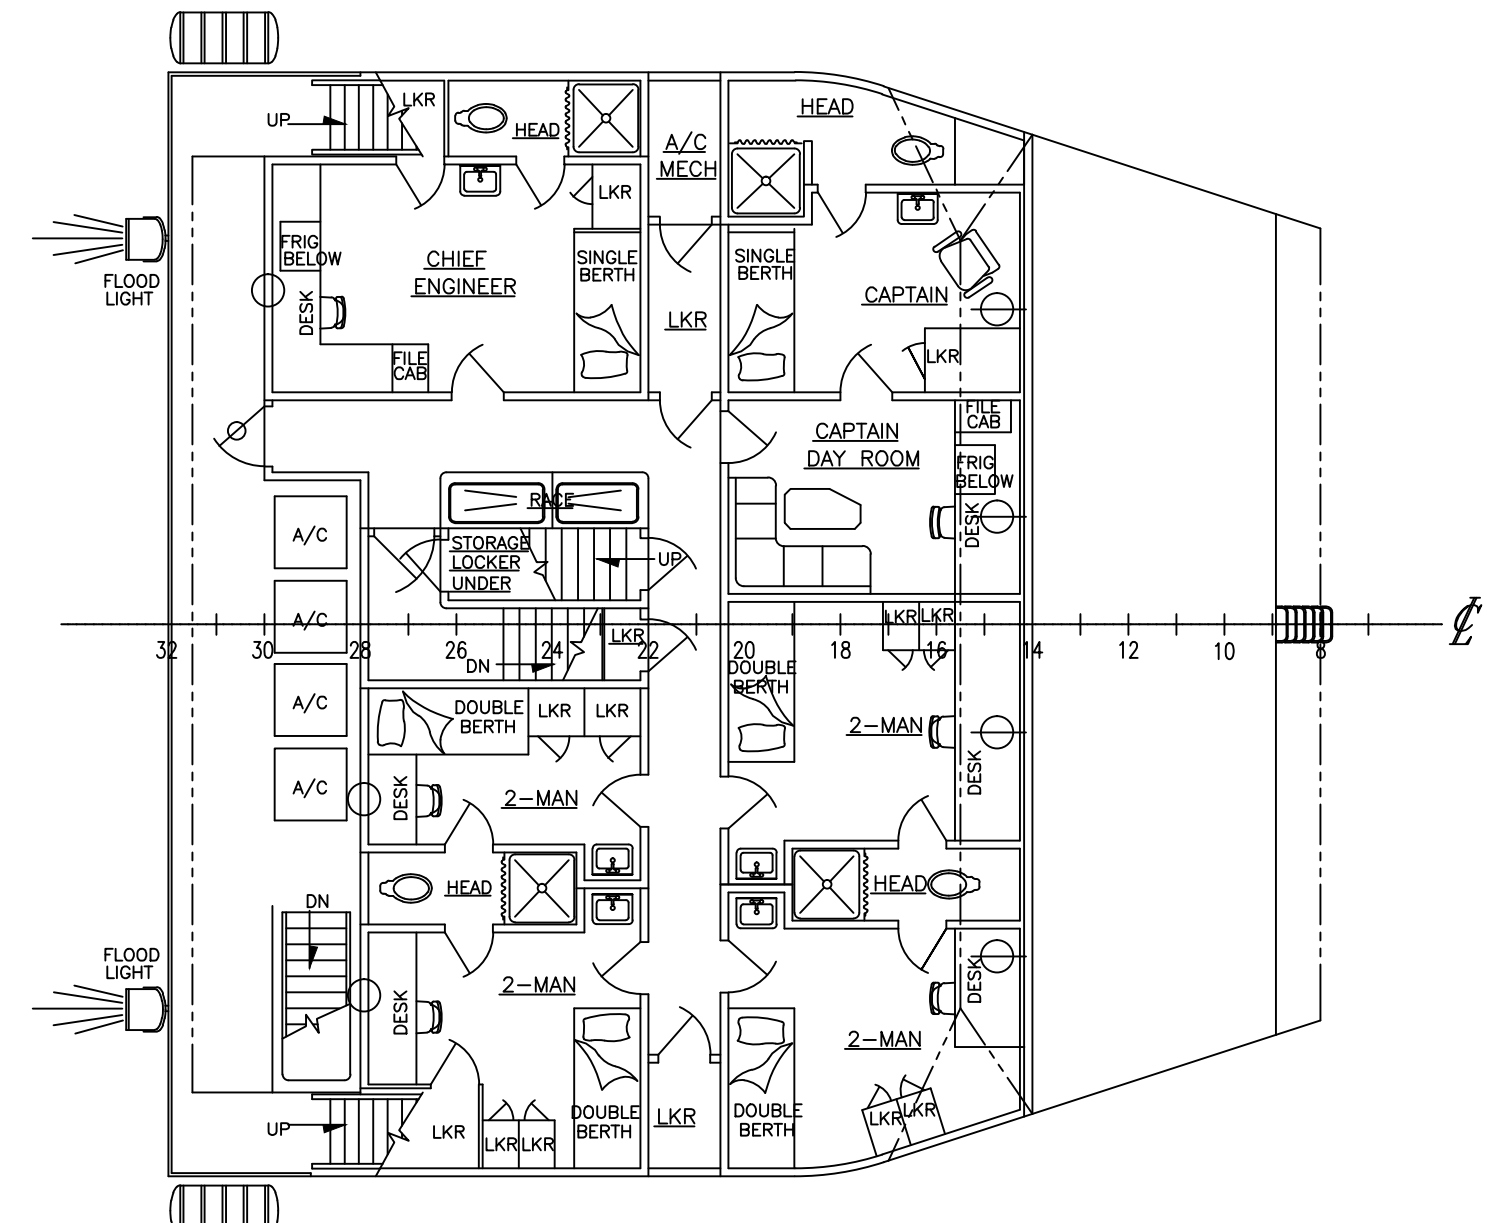

01 LEVEL

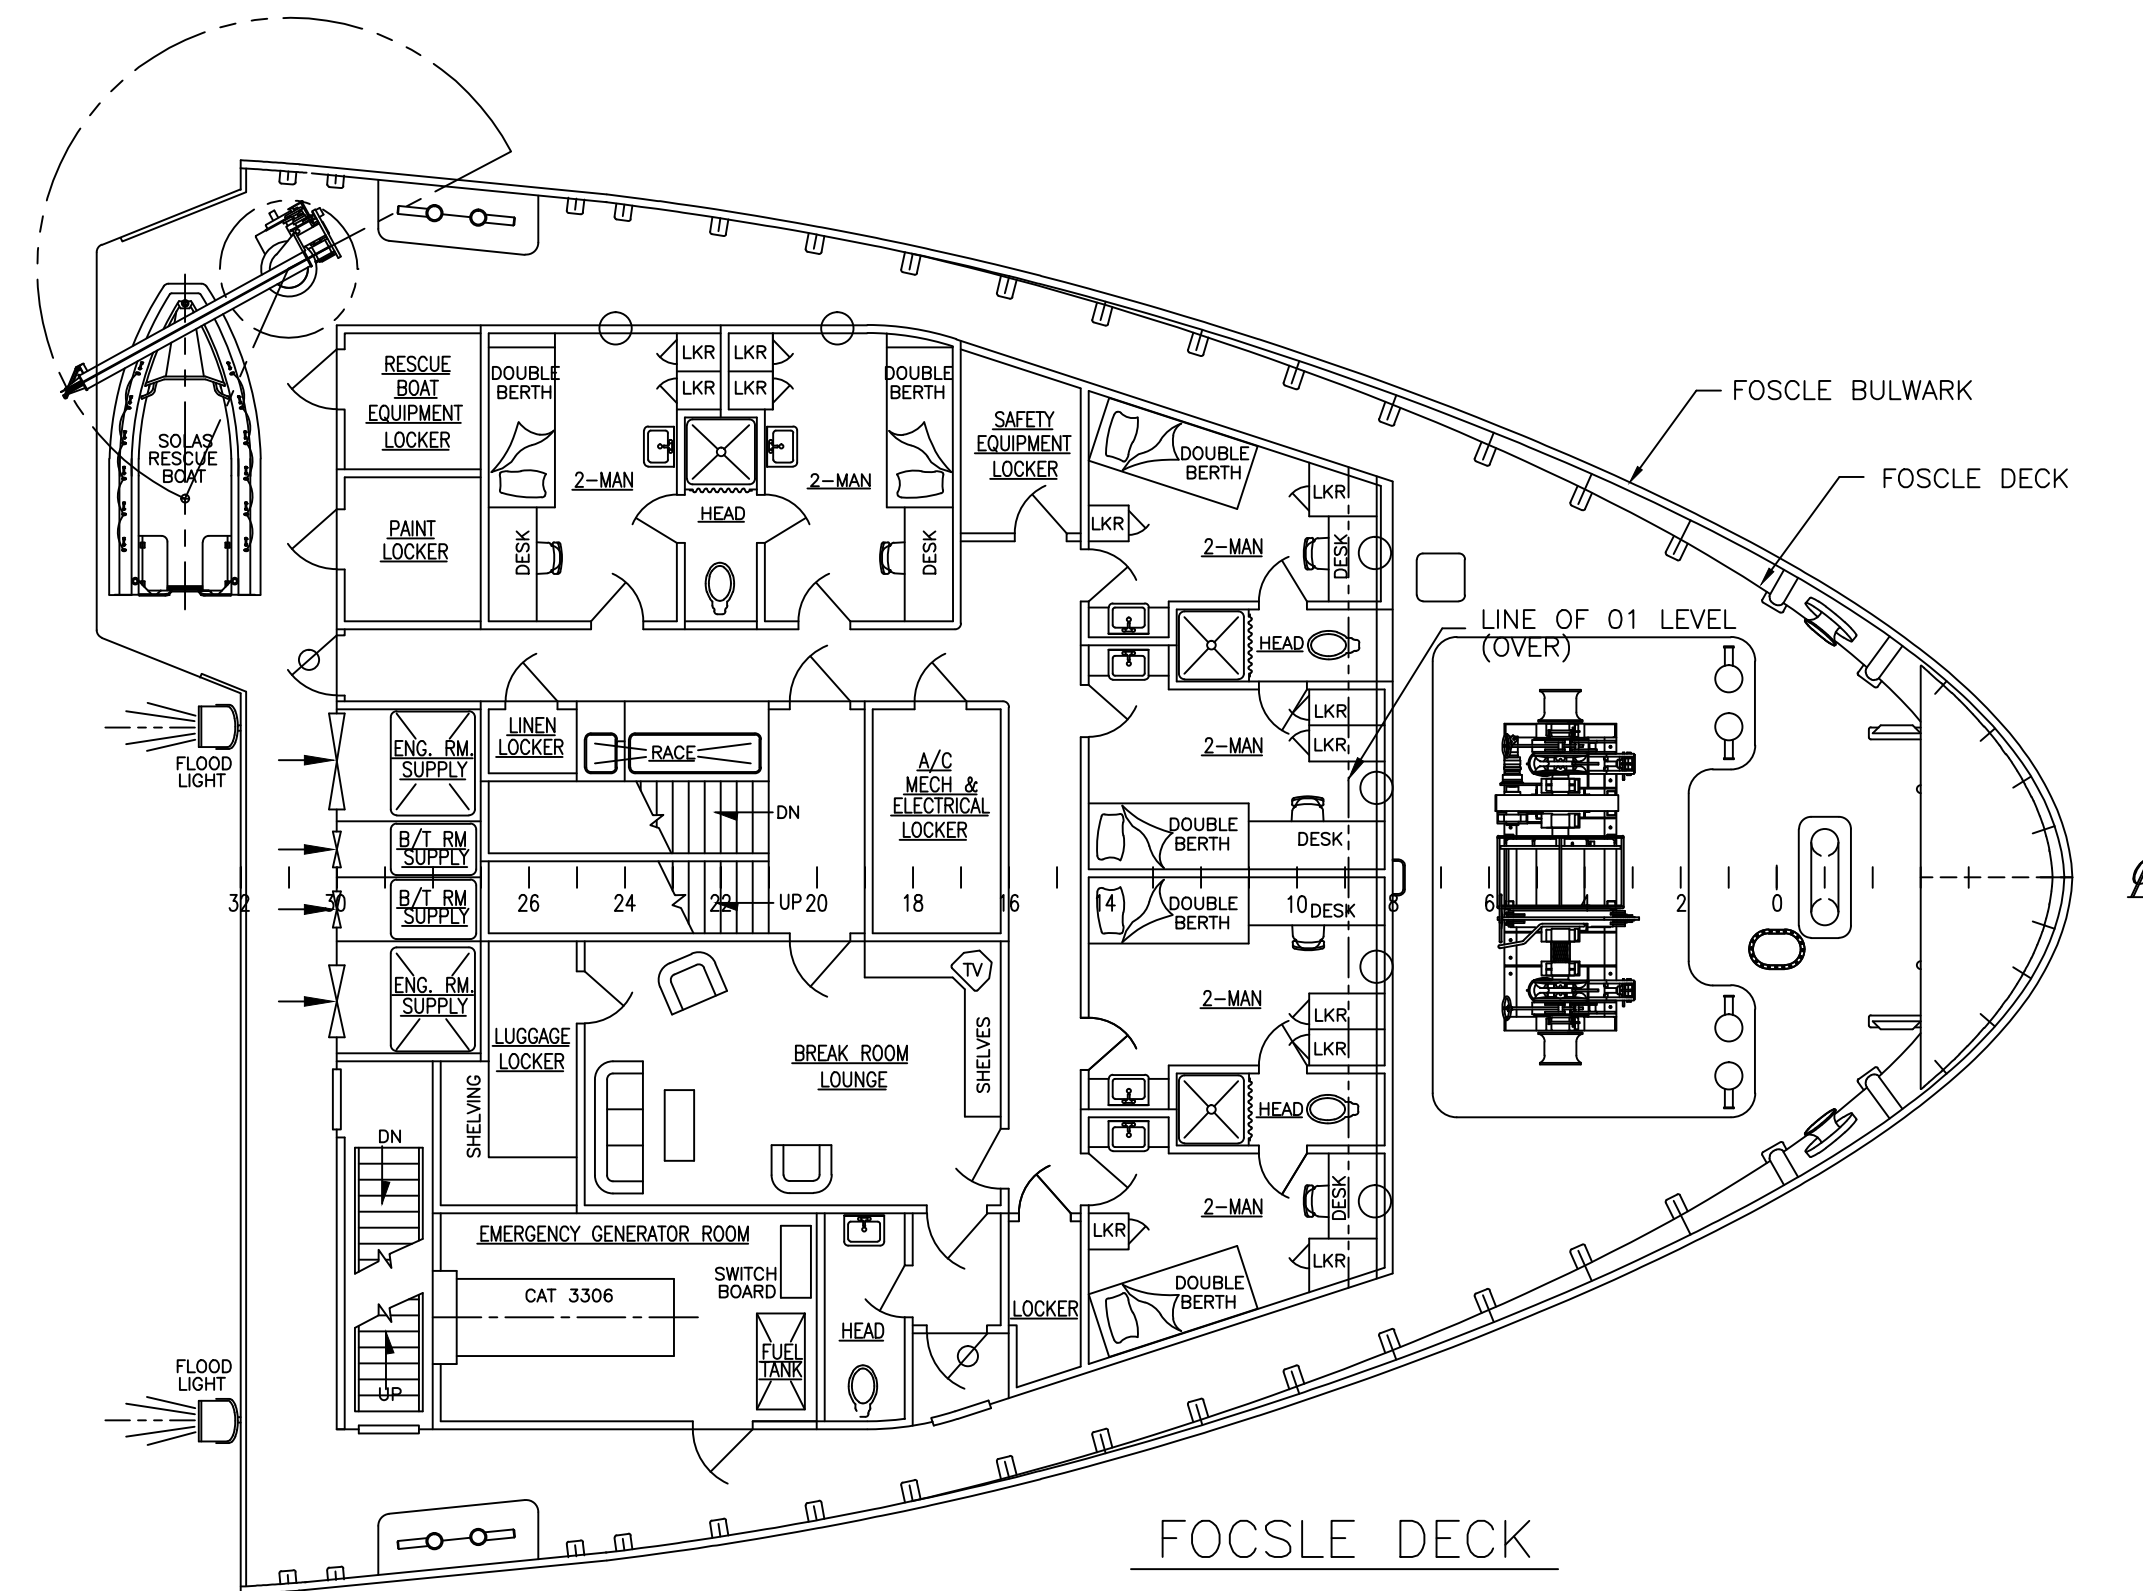


FOCSLE DECK

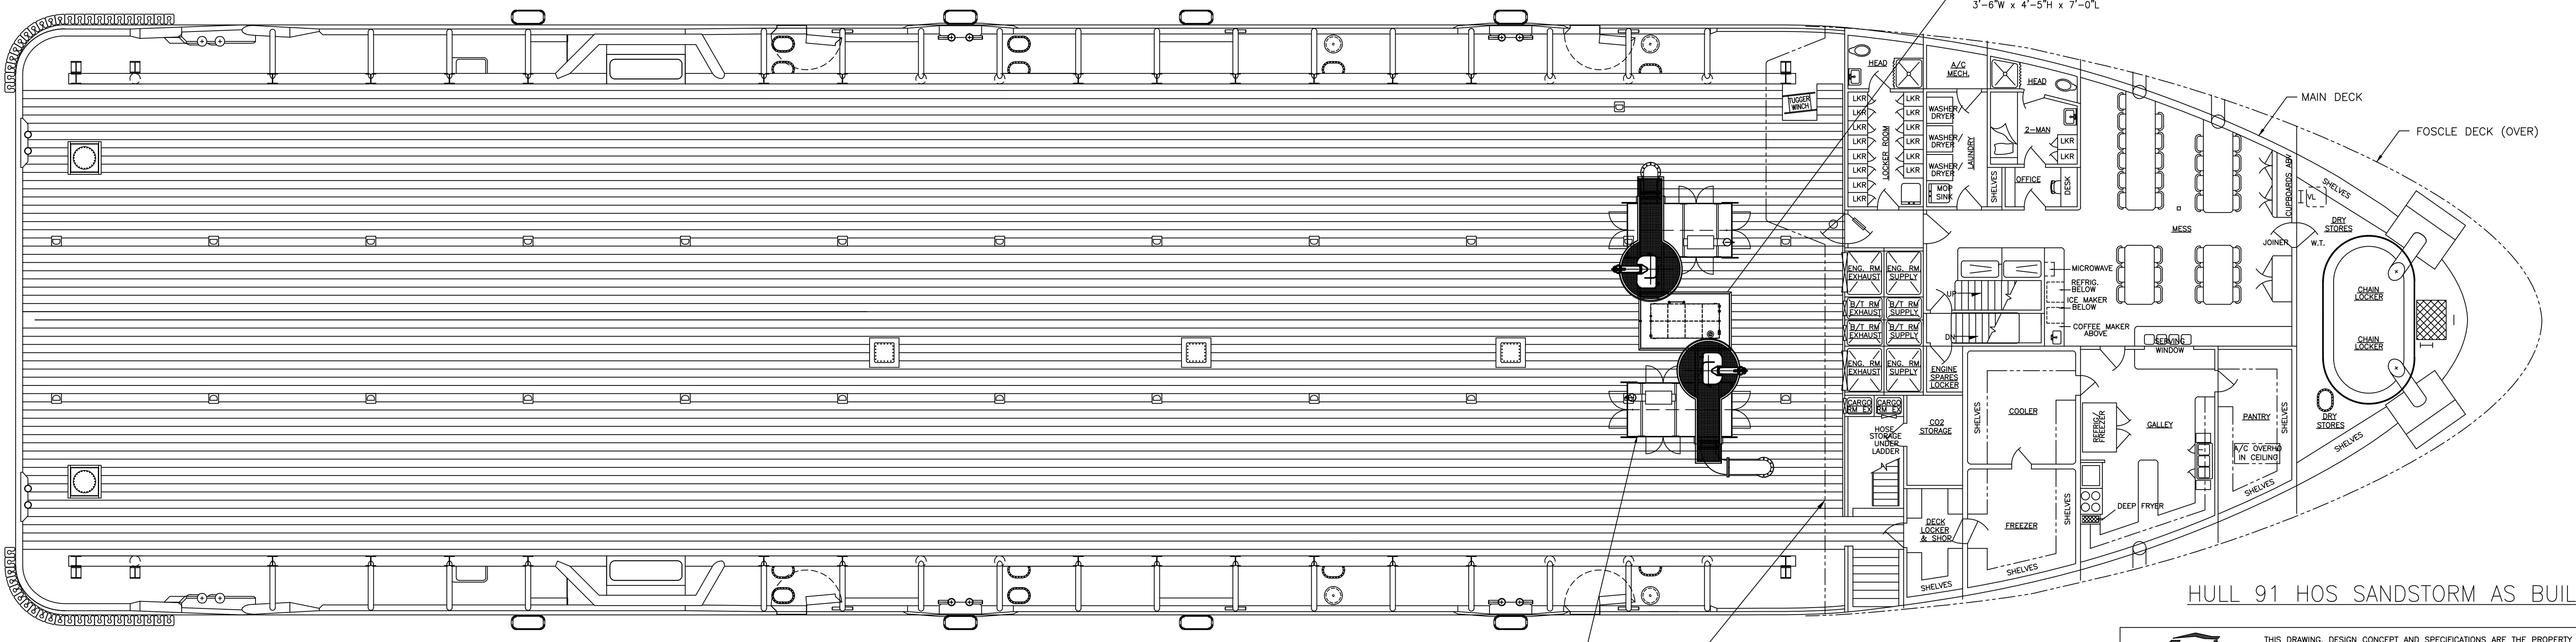

MOONPOOL LAYOUT  
MAIN DECK SECTION

HULL 91 HOS SANDSTORM AS BUILT

 <p>THIS DRAWING, DESIGN CONCEPT AND SPECIFICATIONS ARE THE PROPERTY OF HORNBECK OFFSHORE SERVICES AND ARE FURNISHED ON A CONFIDENTIAL BASIS WITH AN EXPRESSED UNDERSTANDING THAT THEY WILL NOT BE COPIED IN ANY MANNER USED FOR MANUFACTURE, SOLD, TRANSFERRED, NOR USED TO THE DETRIMENT OF SAID FIRM WITHOUT WRITTEN PERMISSION.</p>			
DRAWN BY:		260'-0" X 60'-0" X 21'-0" W	
C. RANDALL			
CH'KD. BY:		GENERAL ARRANGEMENT	
L. BURCHFIELD			
APP'D. BY:		SCALE: 1/8"=1'-0"	DATE: 6/7/2011
L. SANDERS			REV. 5
TASK NO. 5116	DRAWING # 1.002	ASI HULL #91	SHEET 2 OF 2

DECK MOUNTED FIFI SYSTEM  
OUTLINE OF FOCSLE DECK ABOVE