



REVISIONS		
DATE	DESCRIPTION	BY.

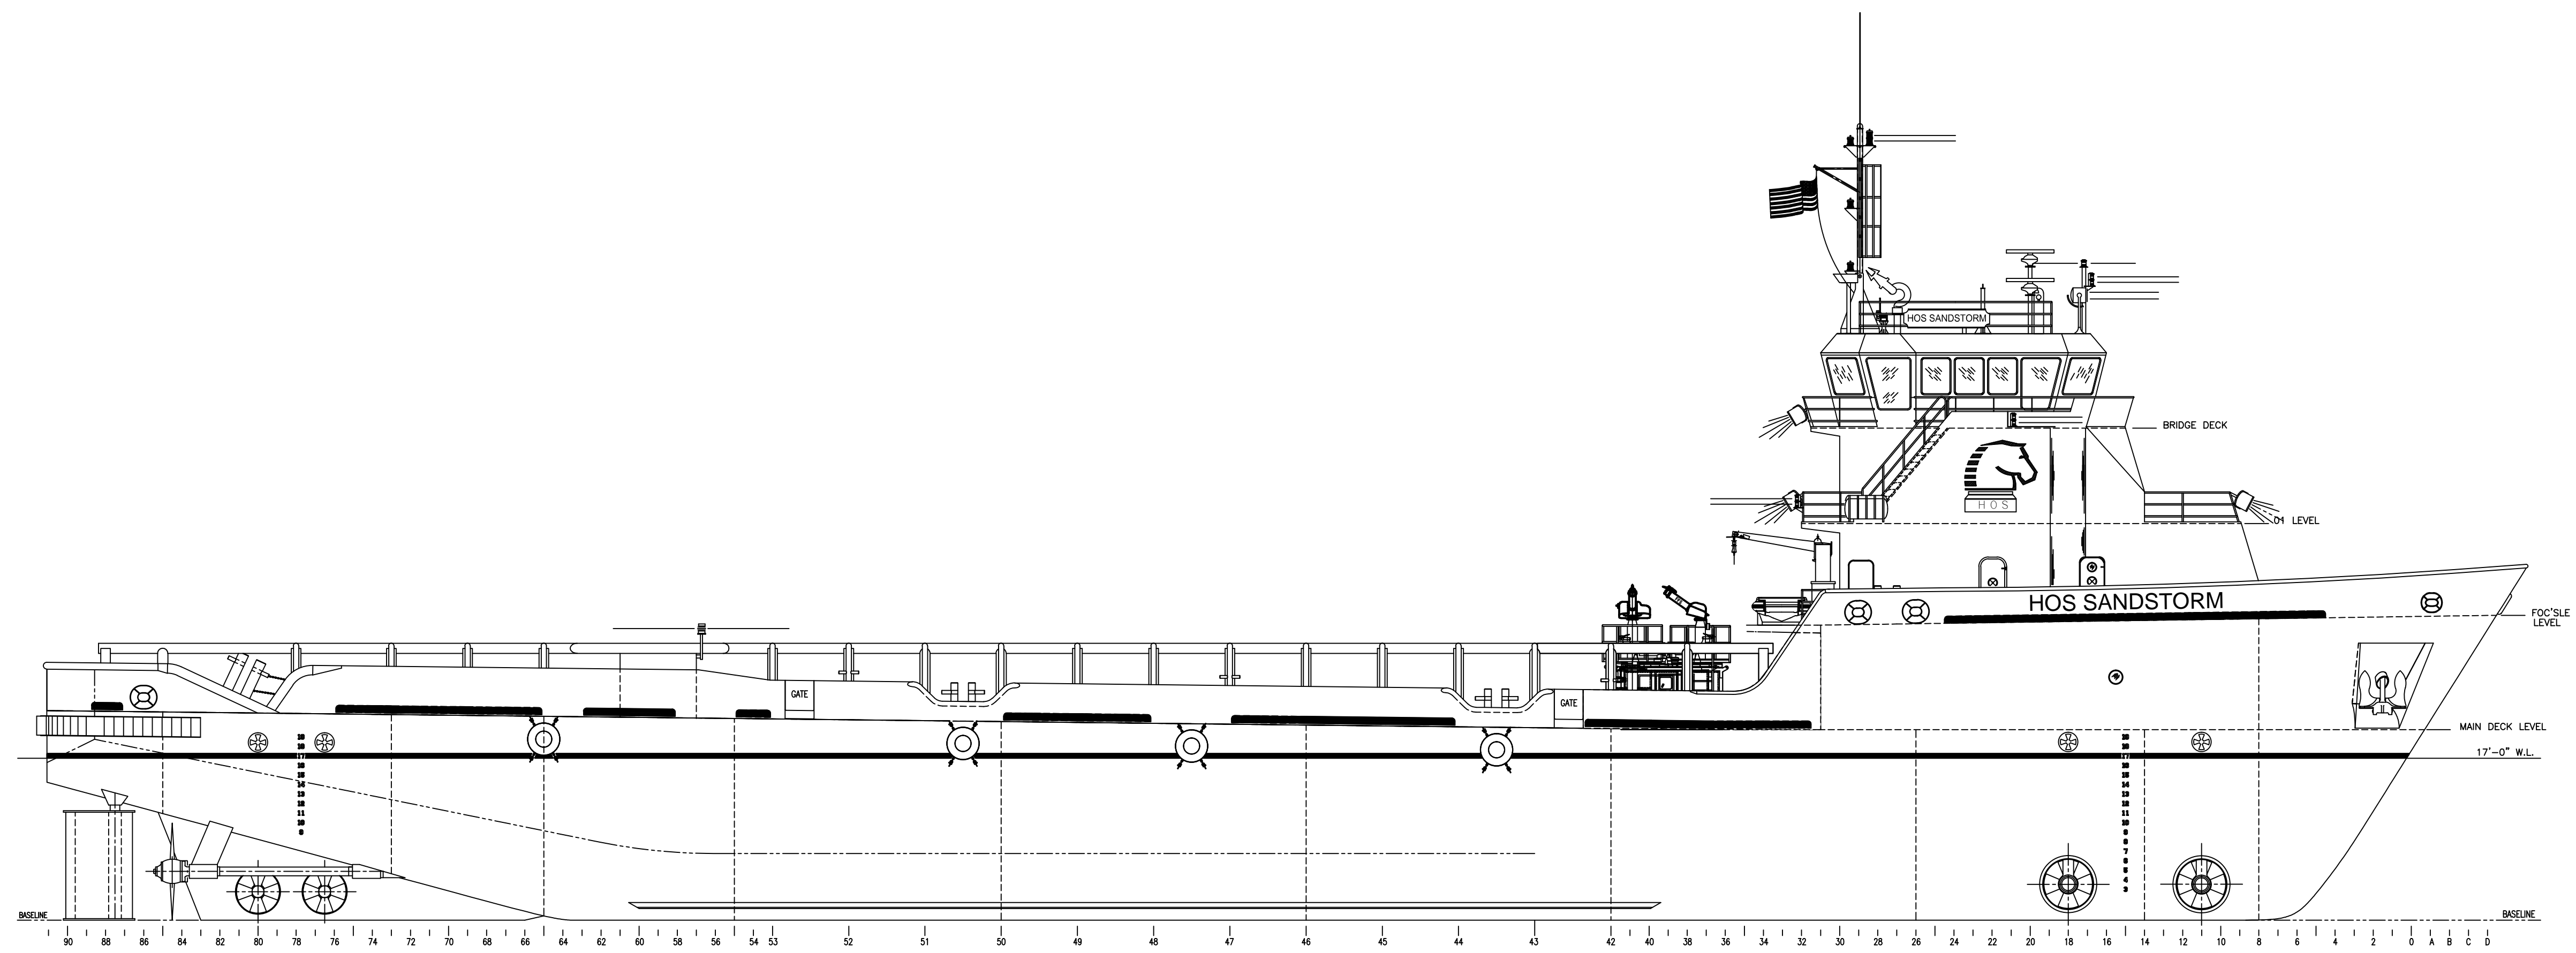

OUTBOARD PROFILE

HULL 91 HOS SANDSTORM AS BUILT

		<small>THIS DRAWING, DESIGN CONCEPT AND SPECIFICATIONS ARE THE PROPERTY OF HORNBECK OFFSHORE SERVICES AND ARE FURNISHED ON A CONFIDENTIAL BASIS WITH AN EXPRESSED UNDERSTANDING THAT THEY WILL NOT BE COPIED IN ANY MANNER USED FOR MANUFACTURE, SOLD, TRANSFERRED, NOR USED TO THE DETRIMENT OF SAID FIRM WITHOUT WRITTEN PERMISSION.</small>	
HORNBECK OFFSHORE SERVICES		<small>HOS ©</small>	
DRAWN BY: C. RANDALL	260'-0" X 60'-0" X 21'-0" W		
CH'KD. BY: L. BURCHFIELD	OUTBOARD PROFILE		
APP'D. BY: L. SANDERS	SCALE: 3/32"=1'-0"	DATE: 6/7/2011	REV.
TASK NO. 5116	DRAWING # 1.001	ASI HULL #91	5
		SHEET 1 OF 2	