




REVISIONS		
DATE	DESCRIPTION	BY.

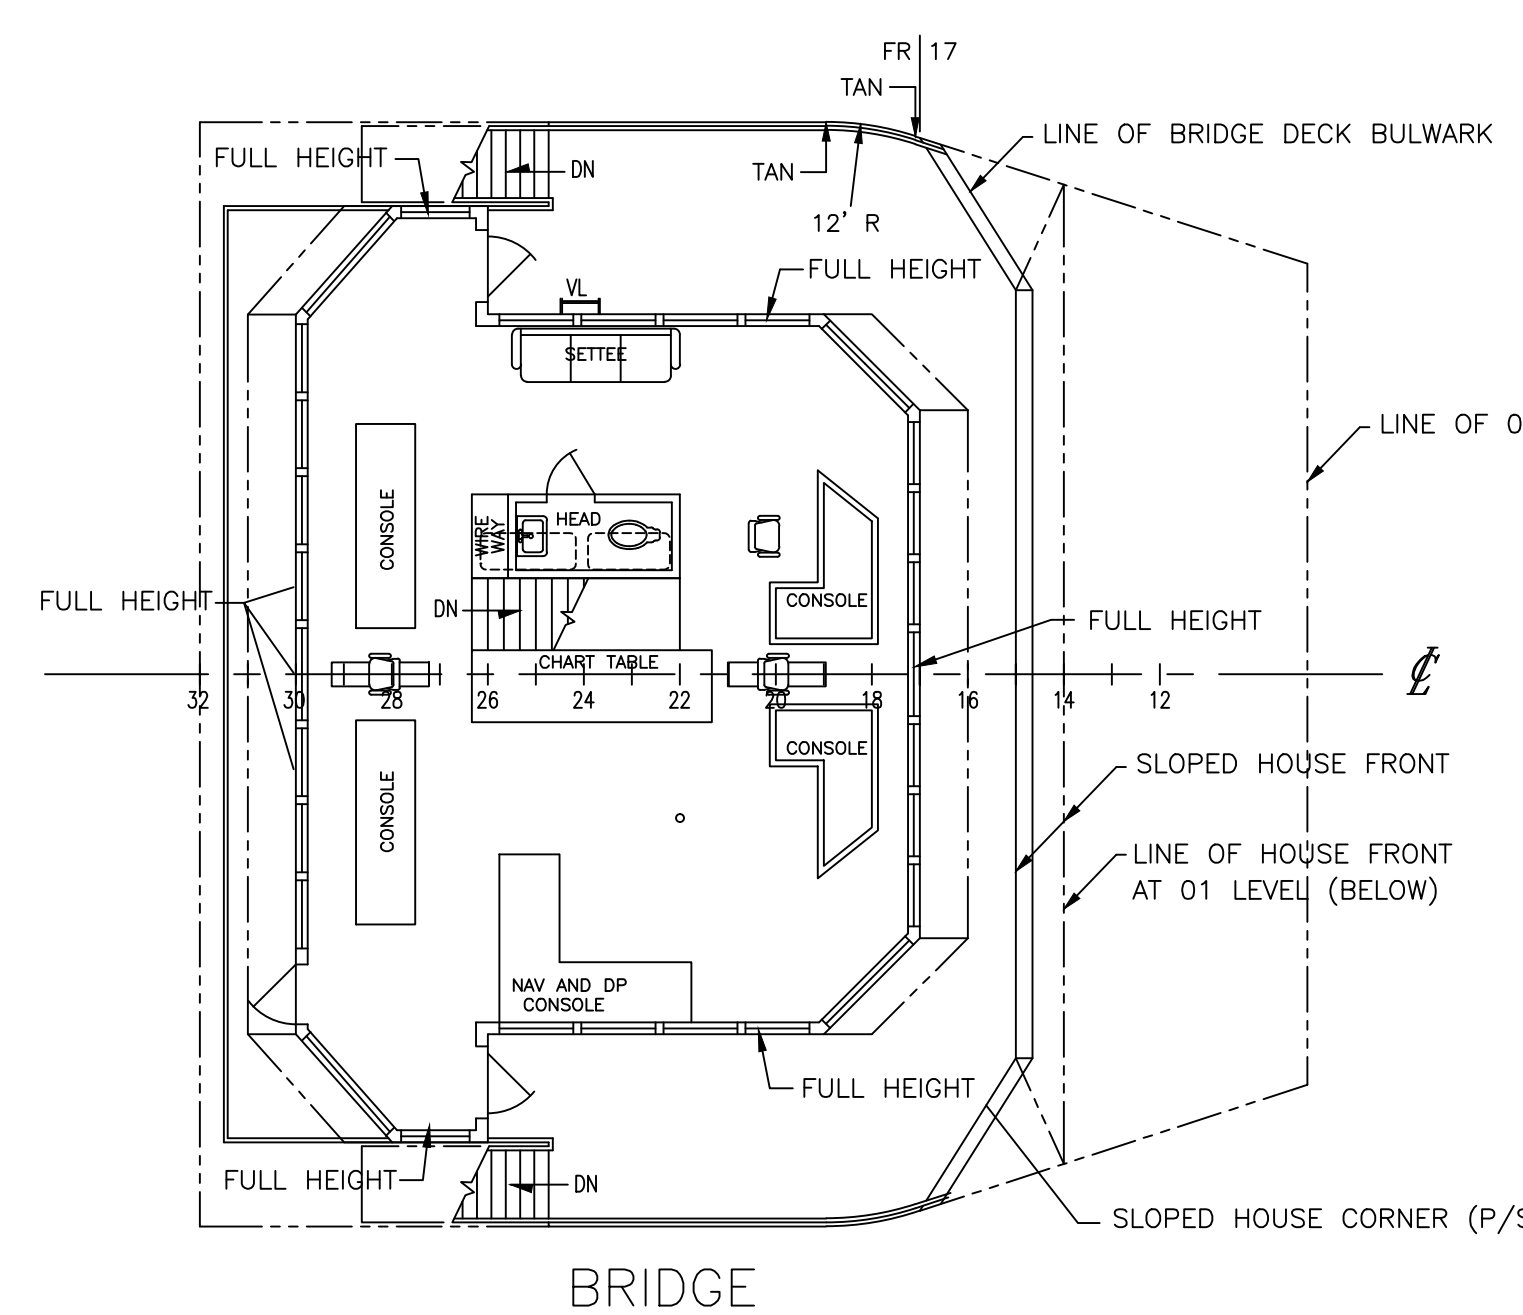


BRIDGE

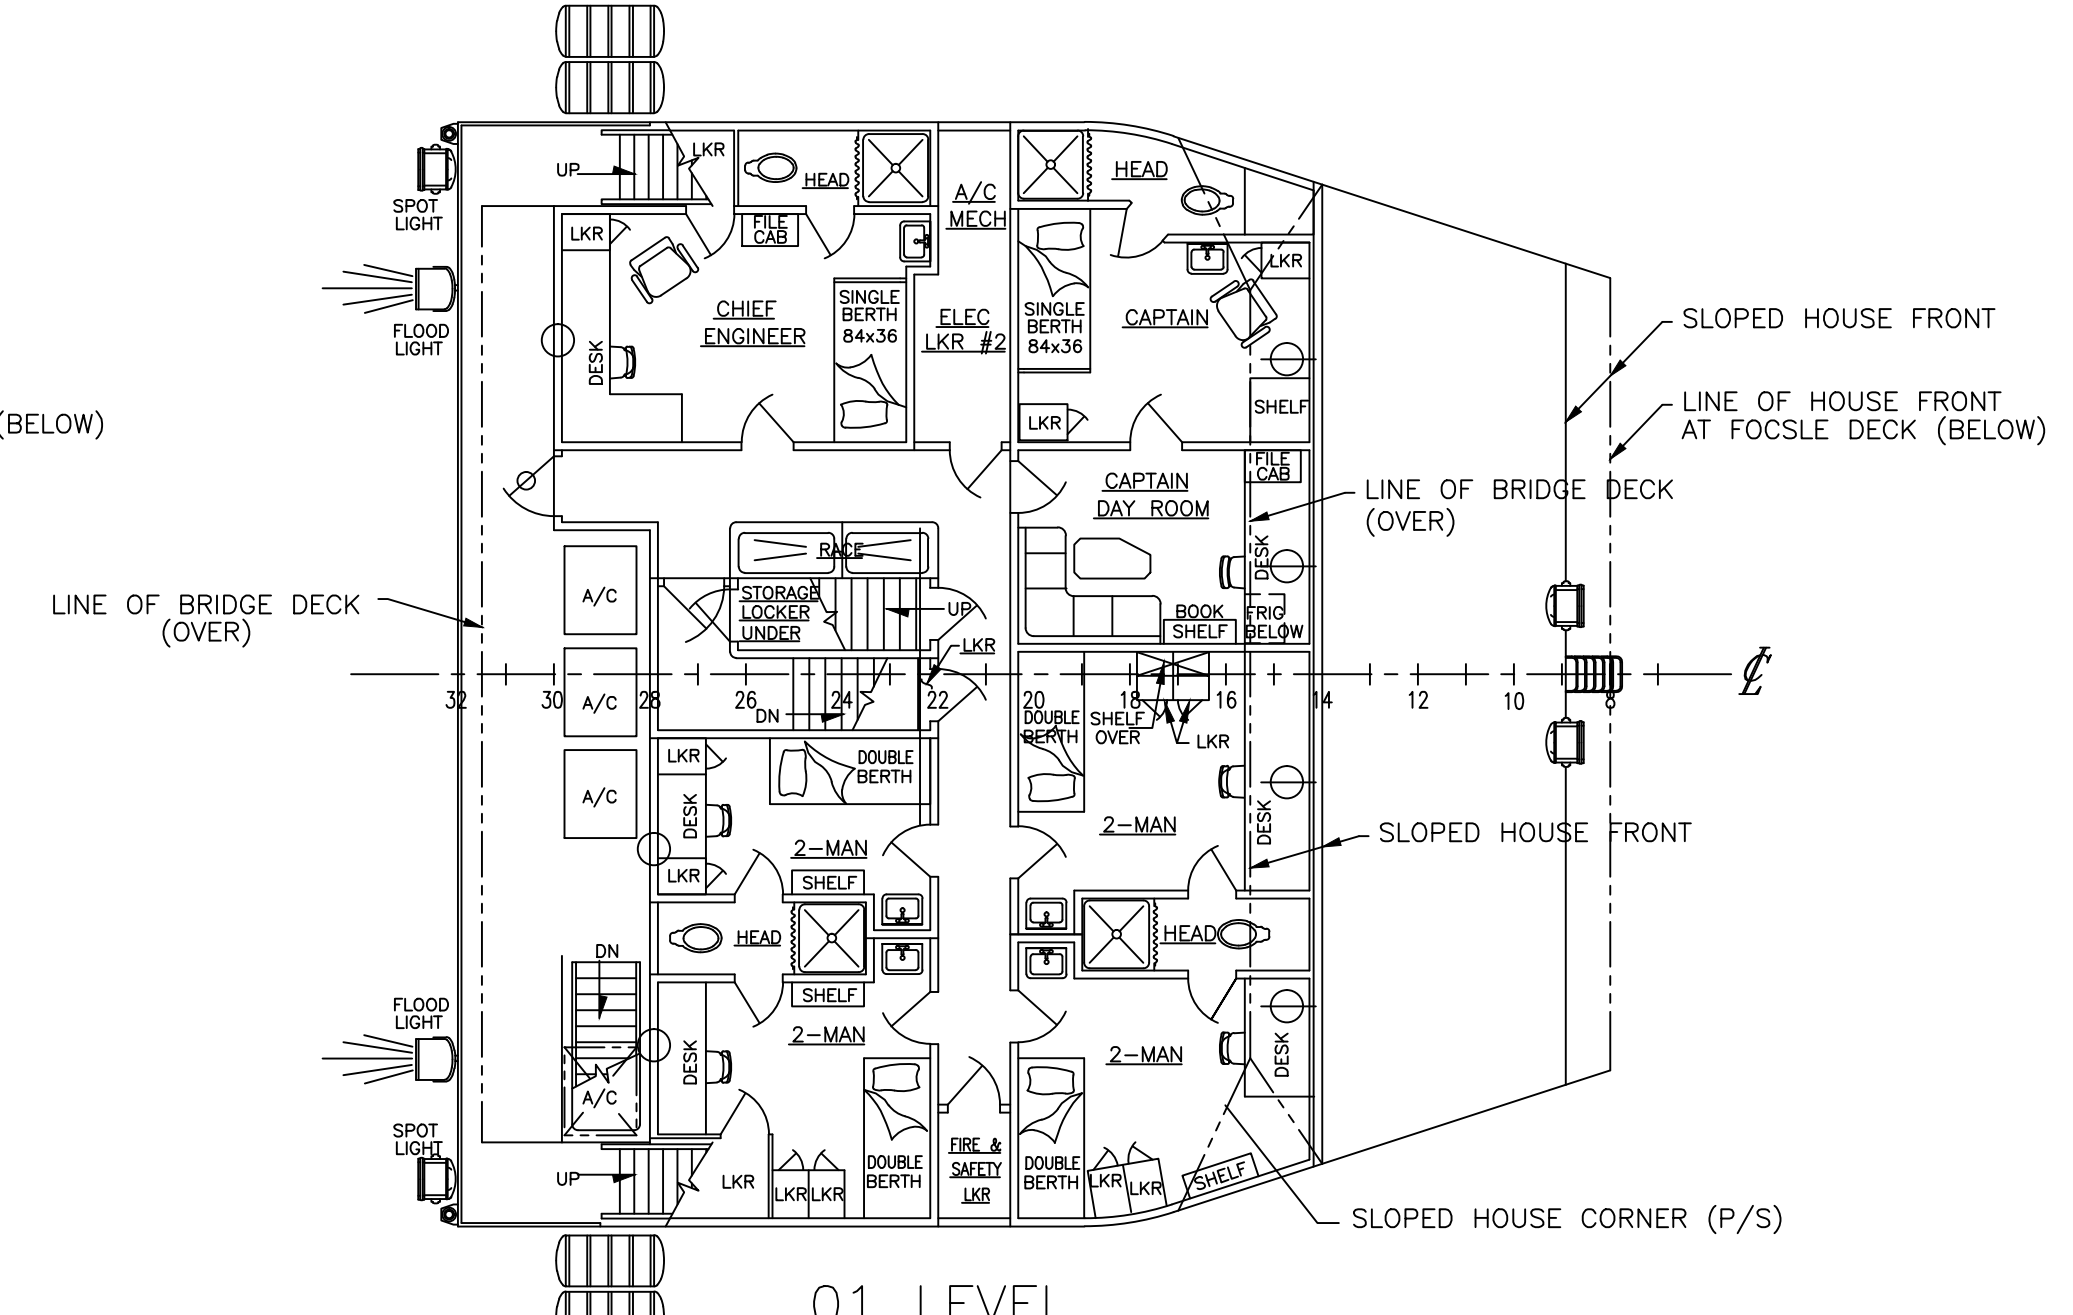

01 LEVEL

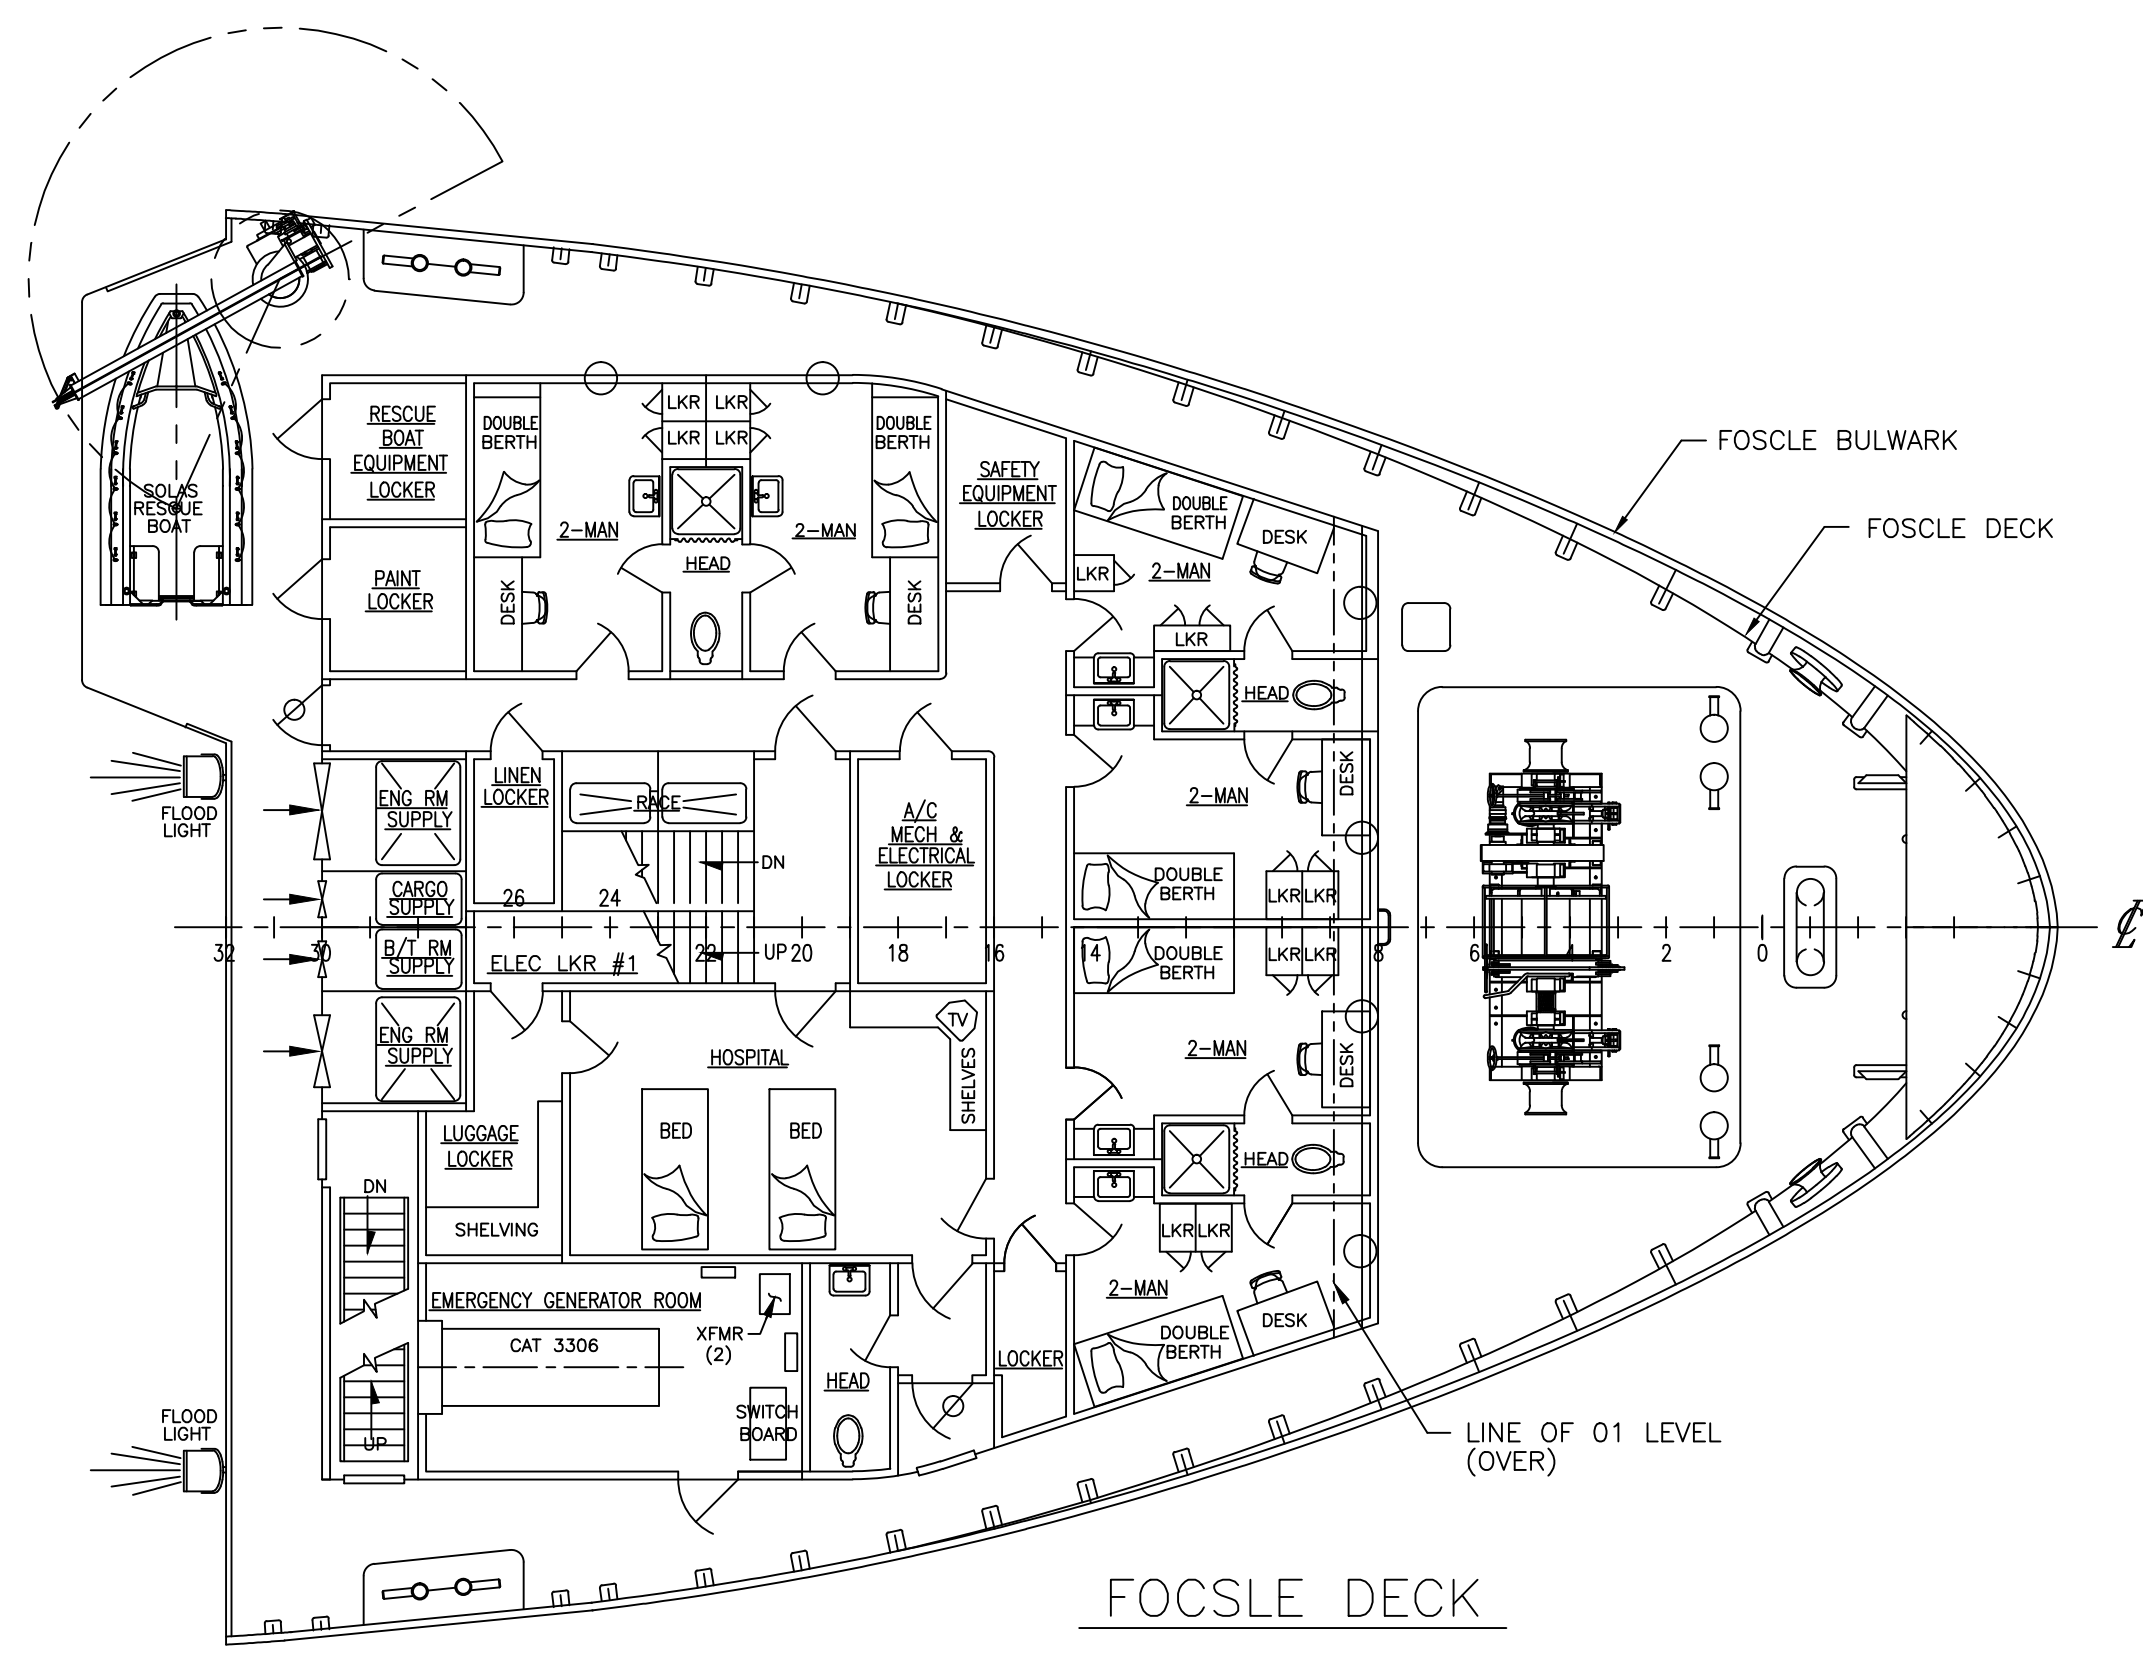


FOSCLE DECK

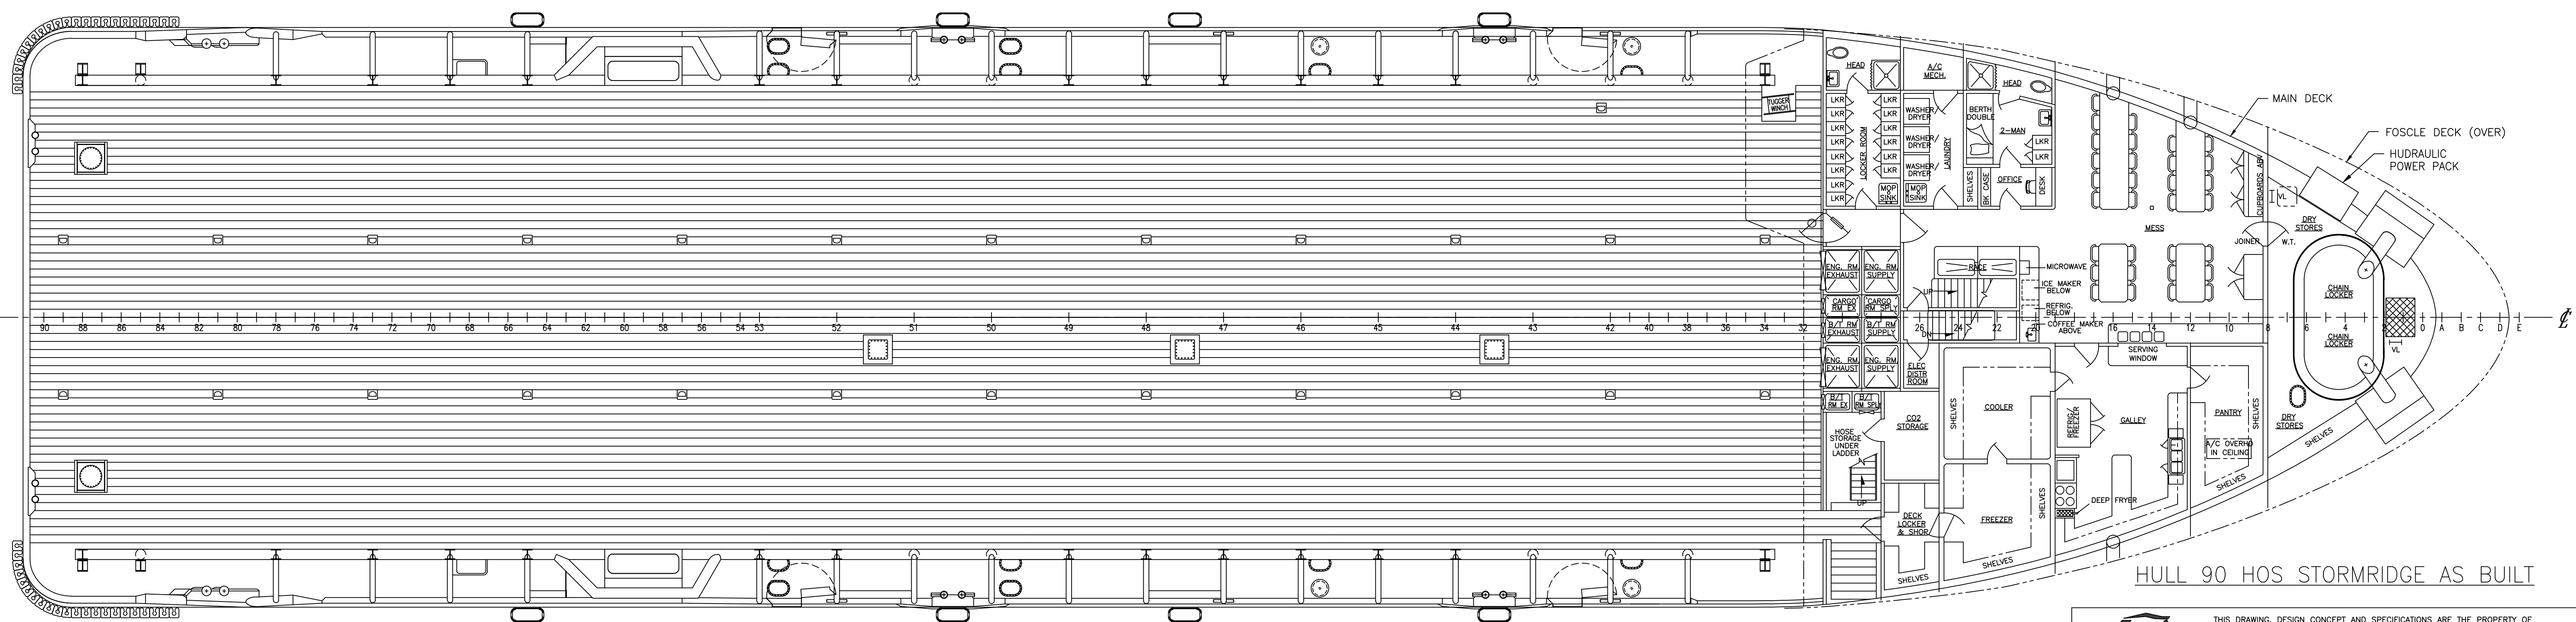

MAIN DECK ARRANGEMENT
20'-0" - 22'-0" ABOVE BASELINE

HULL 90 HOS STORMRIDGE AS BUILT

 <p>THIS DRAWING, DESIGN CONCEPT AND SPECIFICATIONS ARE THE PROPERTY OF HORNBECK OFFSHORE SERVICES AND ARE FURNISHED ON A CONFIDENTIAL BASIS WITH AN EXPRESSED UNDERSTANDING THAT THEY WILL NOT BE COPIED IN ANY MANNER USED FOR MANUFACTURE, SOLD, TRANSFERRED, NOR USED TO THE DETRIMENT OF SAID FIRM WITHOUT WRITTEN PERMISSION.</p>			
<p align="center">HORNBECK OFFSHORE SERVICES</p>			
<p>DRAWN BY: EBDG</p>	<p>260'-0" X 60'-0" X 21'-0" W</p>		
<p>CH'KD. BY: JAT</p>	<p align="center">GENERAL ARRANGEMENT</p>		
<p>APP'D. BY: JAT</p>	<p>SCALE: 1/8"=1'-0"</p>	<p>DATE: 1/19/01</p>	<p>REV.</p>
<p>APP'D. BY:</p>	<p>DRAWING # 1.002</p>	<p>ASI HULL #90 SHEET 1 OF 1</p>	<p>4</p>