

8 7 6 5 4 3 2 1

REVISIONS		
DATE	DESCRIPTION	BY.

D

D

C


C

B

B


A

A

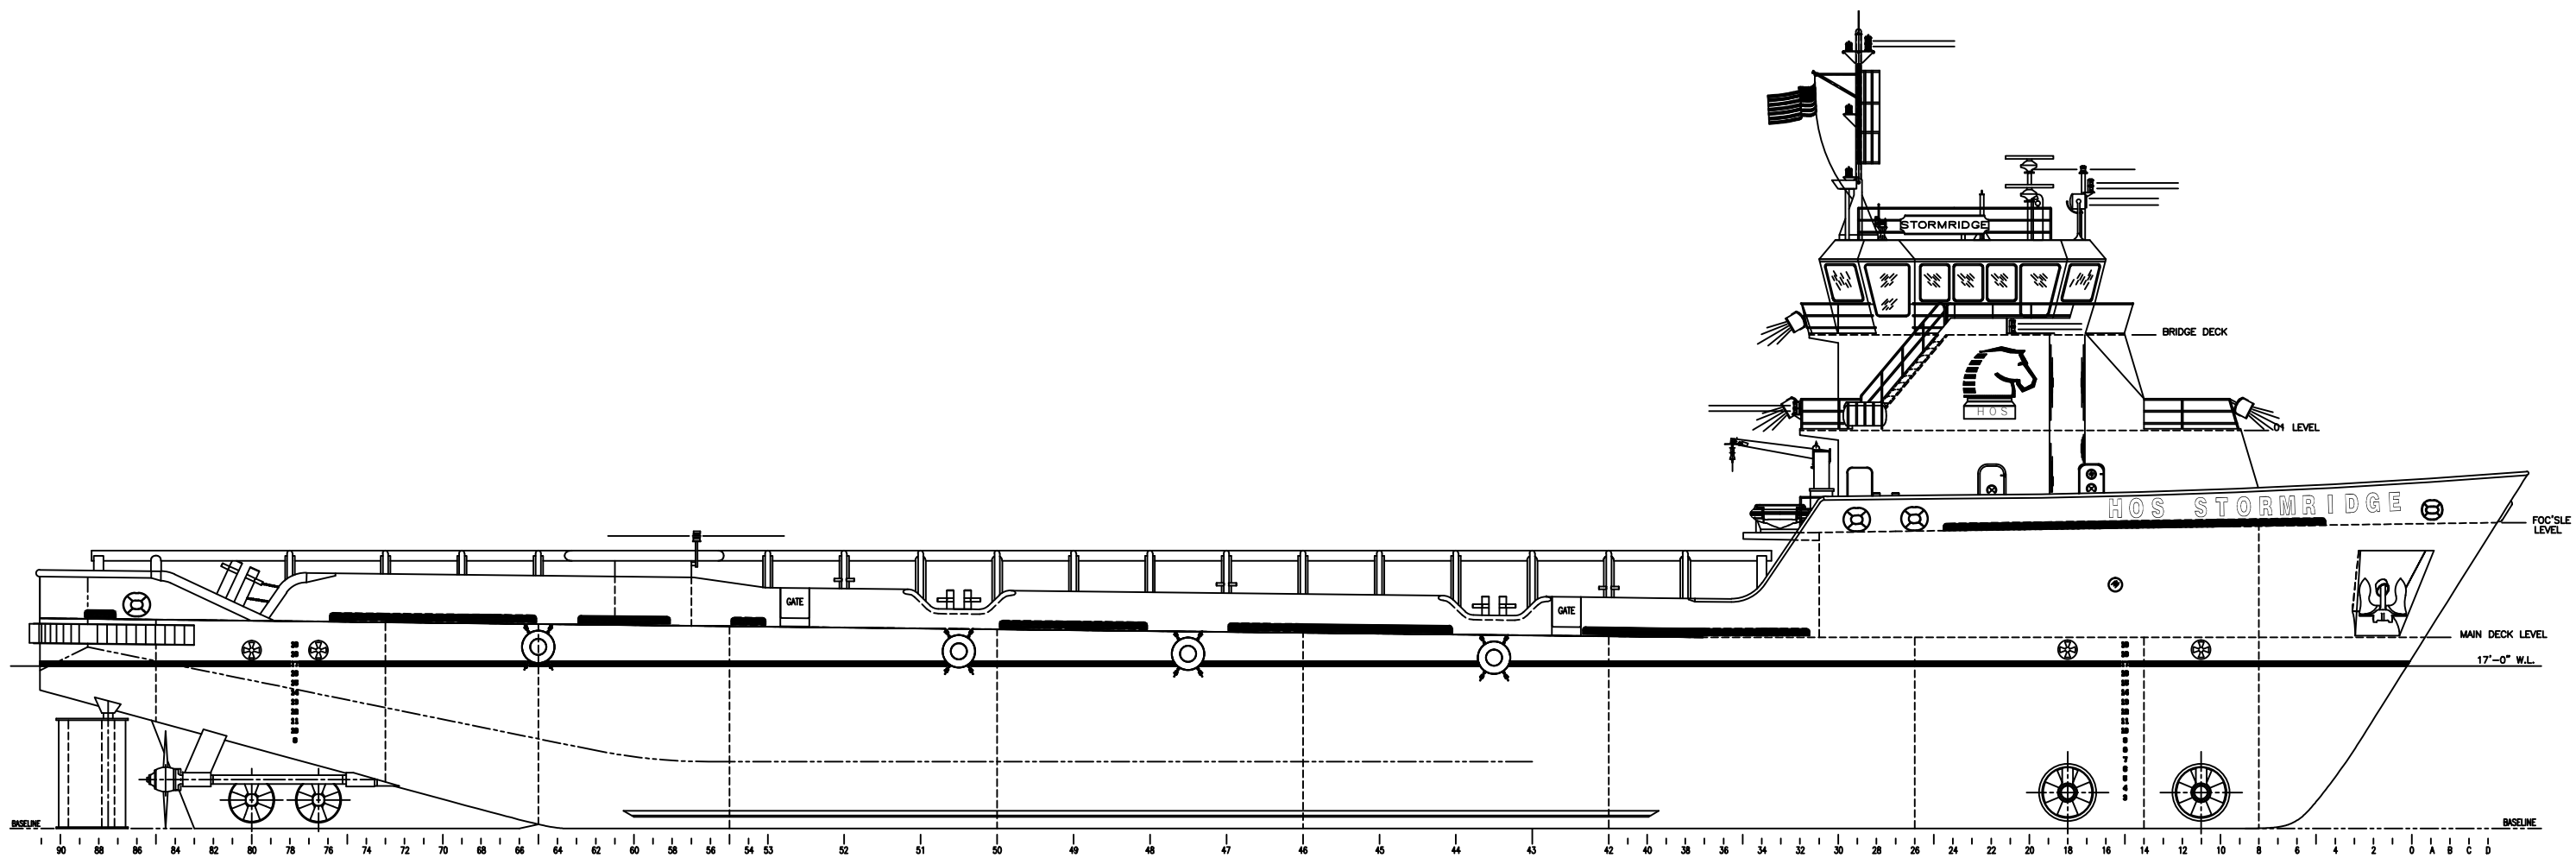

OUTBOARD PROFILE

HULL 90 HOS STORMRIDGE AS BUILT

		<small>THIS DRAWING, DESIGN CONCEPT AND SPECIFICATIONS ARE THE PROPERTY OF HORNBECK OFFSHORE SERVICES AND ARE FURNISHED ON A CONFIDENTIAL BASIS WITH AN EXPRESSED UNDERSTANDING THAT THEY WILL NOT BE COPIED IN ANY MANNER USED FOR MANUFACTURING, SOLD, TRANSFERRED, NOR USED TO THE DETRIMENT OF SAID FIRM WITHOUT WRITTEN PERMISSION. HOS ©</small>	
HORNBECK OFFSHORE SERVICES			
DRAWN BY: EBDG	260'-0" X 60'-0" X 21'-0" W		
CH'KD. BY: JAT	OUTBOARD PROFILE		
APP'D. BY: JAT	SCALE: 1/8"=1'-0"	DATE: 1/19/01	REV.
APP'D. BY:	DRAWING # 1.001	ASI HULL #90 SHEET 1 OF 1	4

8 7 6 5 4 3 2 1