REVISIONS		
REV	DESCRIPTION	DATE
1	GENERAL AS-BUILT REVISION FOR LVI	
2	ADDED BERTH TO PORT STATEROOM ON FOCLSE DECK	6-12-12

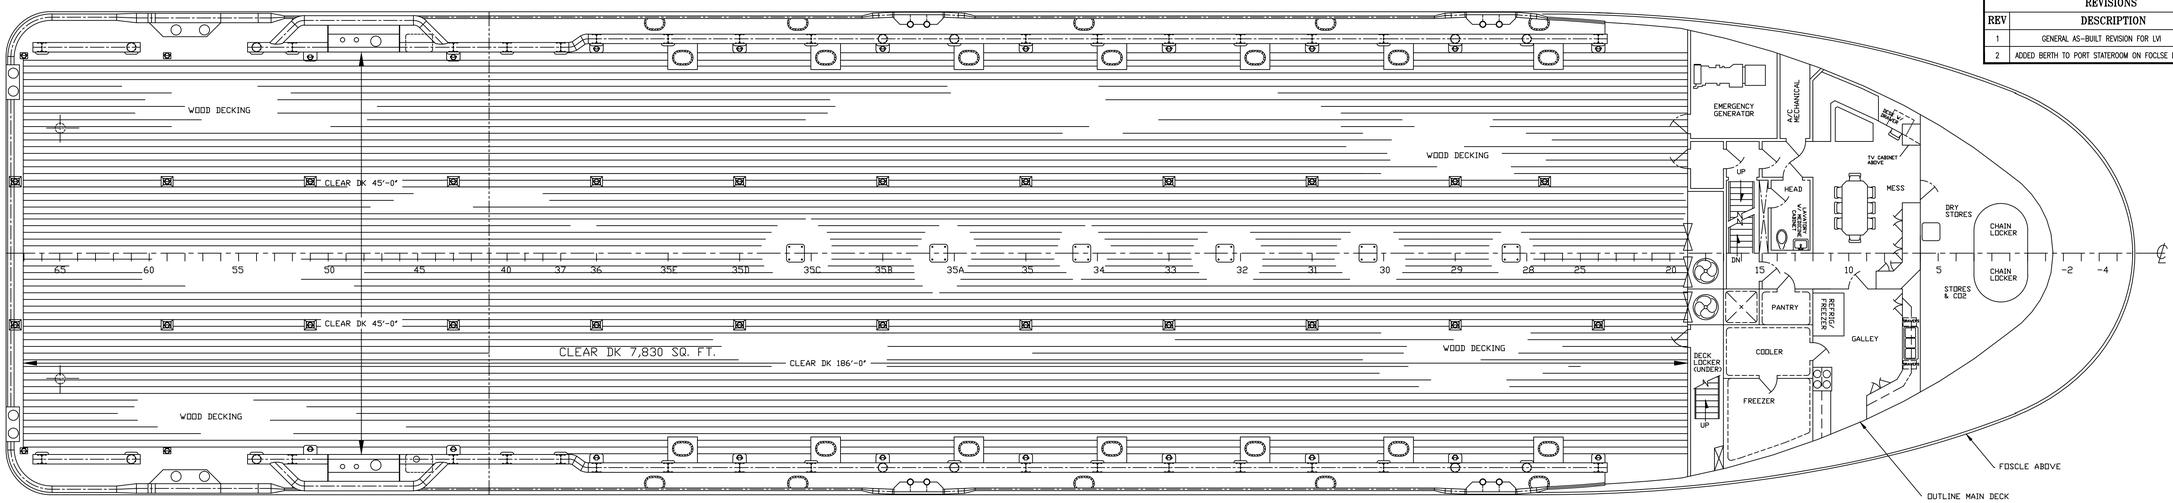

MAIN DECK

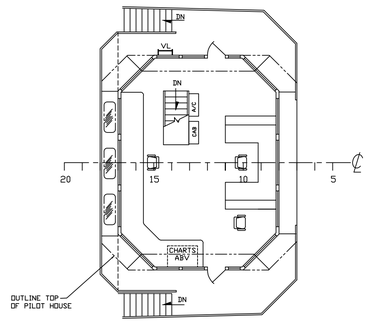

BRIDGE
44'-0" ABOVE BASELINE

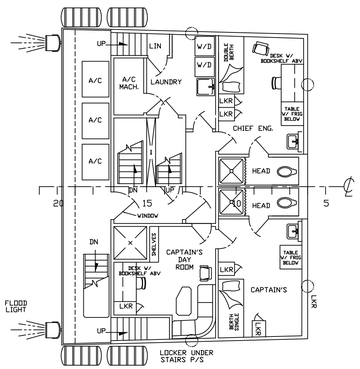

01 LEVEL
35'-0" ABOVE BASELINE

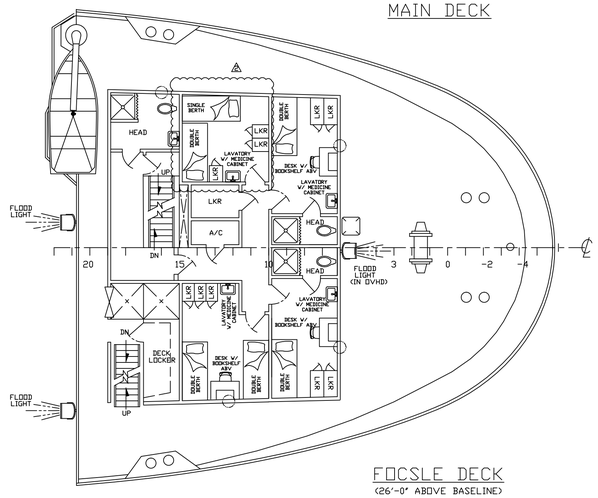

FOCSLE DECK
(26'-0" ABOVE BASELINE)

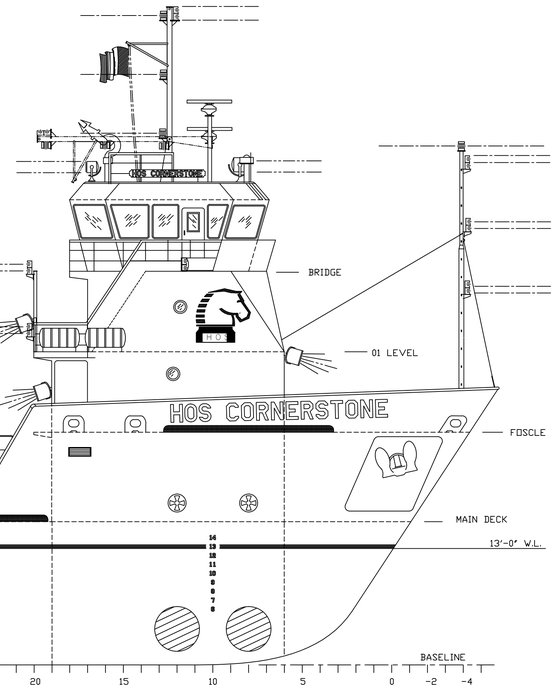

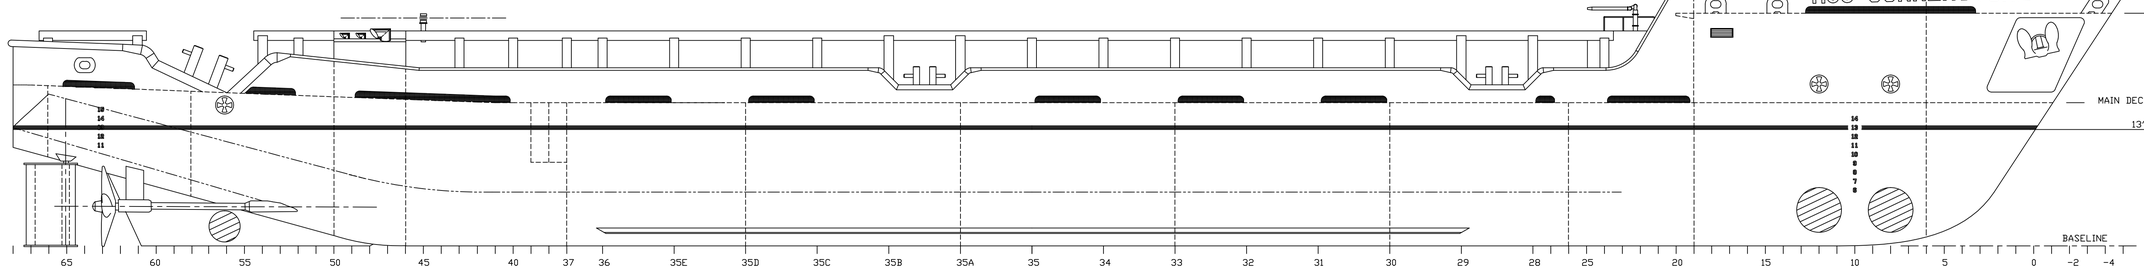

HOS CORNERSTONE

THIS DRAWING, DESIGN CONCEPT AND SPECIFICATIONS ARE THE PROPERTY OF HORNBECK OFFSHORE SERVICES AND ARE FURNISHED ON A CONFIDENTIAL BASIS WITH AN EXPRESSED UNDERSTANDING THAT THEY WILL NOT BE COPIED IN ANY MANNER USED FOR MANUFACTURE, SOLD, TRANSFERRED, NOR USED TO THE DETRIMENT OF SAID FIRM WITHOUT WRITTEN PERMISSION. HOS ©

HORNBECK OFFSHORE SERVICES

DRAWN BY: C. Holman	238'-0" X 54'-0" X 16'-0" OSV		
CH'KD. BY: L. Burchfield	PROFILE & ARRANGEMENTS		
APP'D. BY: L. Sanders	SCALE: 1/8" = 1' - 0"	DOB: 12/29/99	REV. 2
PROJECT # 5153	DRAWING # 1.001	HULL: LEEVAC IND 325	
		SHEET 1 OF 1	